

STATE CORPORATION COMMISSION OF KANSAS
OIL & GAS CONSERVATION DIVISION

WELL COMPLETION OR RECOMPLETION FORM
ACO-1 WELL HISTORY

DESCRIPTION OF WELL AND LEASE

Operator: license # 5118
name TGT Petroleum Corp.
address 209 E. William
City/State/Zip Wichita, Ks. 67202

Operator Contact Person B. Lynn Herrington
Phone 262-6489

Contractor: license # 5422
name Abercrombie Drilling, Inc.

Wellsite Geologist Al Stude
Phone 262-0902
PURCHASER Permian Corp.

Designate Type of Completion
 New Well Re-Entry Workover

Oil SWD Temp Abd
 Gas Inj Delayed Comp.
 Dry Other (Core, Water Supply etc.)

If OWWO: old well info as follows:
Operator
Well Name
Comp. Date Old Total Depth

WELL HISTORY

Drilling Method: Mud Rotary Air Rotary Cable
7/27/85 8/7/85 9/18/85
Spud Date Date Reached TD Completion Date
4907 4879
Total Depth PBTD

Amount of Surface Pipe Set and Cemented at 438 feet

Multiple Stage Cementing Collar Used? Yes No

If Yes, Show Depth Set feet

If alternate 2 completion, cement circulated from feet depth to w/ SX cmt

API NO. 15-097-21,168
County Kiowa
Approx. C
S/2 S/2 NW Sec. 6 Twp. 28S Rge. 18 X W
(location)

2970 Ft North from Southeast Corner of Section
3980 Ft West from Southeast Corner of Section
(Note: locate well in section plat below)


Lease Name Colclazier Well# 4

Field Name Einsel

Producing Formation See side 2

Elevation: Ground 2253 KB 2265

Section Plat

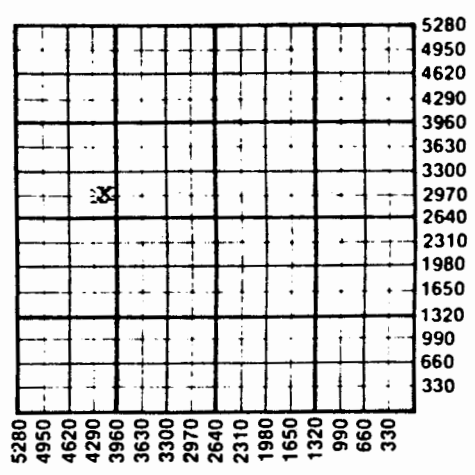

DEC 0 1 1985

State Geological Survey
WICHITA

WATER SUPPLY INFORMATION

Source of Water:
Division of Water Resources Permit #

Groundwater 2990 Ft North From Southeast Corner of (Well) 4080 Ft. West From Southeast Corner Sec 6 Twp 28S Rge 18 East West

Surface Water Ft North From Southeast Corner of (Stream, Pond etc.) Ft West From Southeast Corner Sec Twp Rge East West

Other (explain) (purchased from city, R.W.D.#)

Disposition of Produced Water: Disposal Repressuring

Docket #

INSTRUCTIONS: This form shall be completed in duplicate and filed with the Kansas Corporation Commission, 200 Colorado Derby Building Wichita, Kansas 67202, within 90 days after completion or recompletion of any well. Rules 82-3-130 and 82-3-107 apply.

Information on side two of this form will be held confidential for a period of 12 months if requested in writing and submitted with the form. See rule 82-3-10 for confidentiality in excess of 12 months.

One copy of all wireline logs and drillers time log shall be attached with this form. Submit CP-4 form with all plugged wells. Submit CP-111 form with