

ind ✓ P

STATE CORPORATION COMMISSION OF KANSAS
OIL & GAS CONSERVATION DIVISION
WELL COMPLETION OR RECOMPLETION FORM
ACO-1 WELL HISTORY

DESCRIPTION OF WELL AND LEASE

Operator: license # 5118
name TGT Petroleum Corp.
address 209 E. William
City/State/Zip Wichita, Ks. 67202

Operator Contact Person B. Lynn Herrington
Phone 262-6489

Contractor: license # 5422
name Abercrombie Drilling, Inc.

Wellsite Geologist Al. Stude
Phone 262-0902

PURCHASER Clear Creek

Designate Type of Completion
 New Well Re-Entry Workover

Oil SWD Temp Abd
 Gas Inj Delayed Comp.
 Other (Core, Water Supply etc.)

Old Well Info (OWWO):
Operator
Well Name
Comp. Date Old Total Depth

WELL HISTORY

Drilling Method: Mud Rotary Air Rotary Cable
9-23-1985
9/23/85 10/5/85 11/29/85
pub. Date Date Reached TD Completion Date
4920 4906
Total Depth PBDT

Installation of Surface Pipe Set and Cemented at 438 feet
Multiple Stage Cementing Collar Used? Yes No

If Yes, Show Depth Set feet
Alternate 2 completion, cement circulated
from feet depth to w/ SX cmt

API NO. 15 - 097-21,182

County Kiowa

Approx. location NE NW SW Sec 6 Twp 28S Rge 18 West
2310 Ft North from Southeast Corner of Section
3980 Ft West from Southeast Corner of Section
(Note: locate well in section plat below)


Lease Name Gary William Well# 4

Field Name Einsel

Producing Formation See side 2

Elevation: Ground 2260 KB 2272

Section Plat

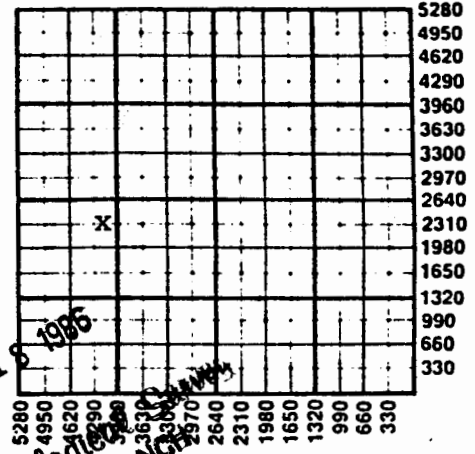

FEB 18 1986

STATE WATER SUPPLY INFORMATION

Division of Water Resources Permit #

Groundwater 2100 Ft North From Southeast Corner and
(Well) 4620 Ft. West From Southeast Corner of
Sec 6 Twp 28S Rge 18 East West

Surface Water Ft North From Southeast Corner and
(Stream, Pond etc.) Ft West From Southeast Corner
Sec Twp Rge East West

Other (explain)
(purchased from city, R.W.D.#)

Disposition of Produced Water: Disposal Repressuring

Docket #

INSTRUCTIONS: This form shall be completed in duplicate and filed with the Kansas Corporation Commission, 200 Colorado Derby Building, Wichita, Kansas 67202, within 90 days after completion or recompletion of any well. Rules 82-3-130 and 82-3-107 apply.

Information on side two of this form will be held confidential for a period of 12 months if requested in writing and submitted with the form. See rule 82-3-107 for confidentiality in excess of 12 months.

One copy of all wireline logs and drillers time log shall be attached with this form. Submit CP-4 form with all plugged wells. Submit CP-111 form with temporarily abandoned wells.