


DX 78-1

Kingman KANSAS

Section 18 Township 28 Range 5 W

Well No. # 1 Clouse

Company Lario Oil & Gas

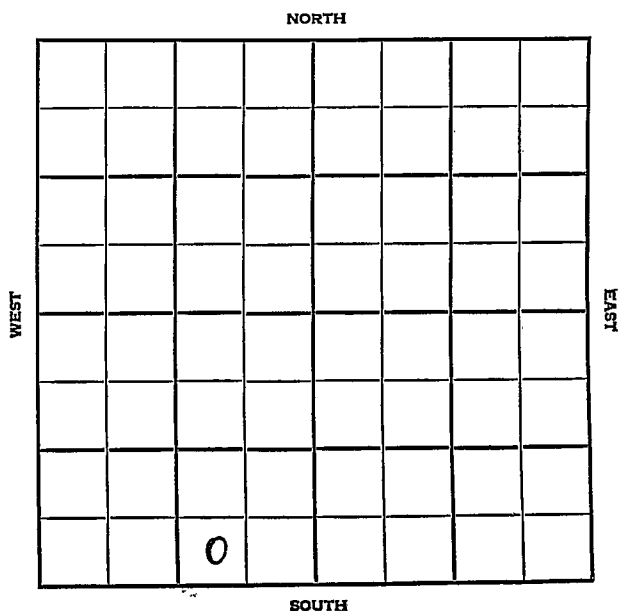

Kingman KANSAS

SEC.	TWP.	R.
18	28	5W

WELL NO.

1 Clouse

FARM

COMPANY

Lario Oil & Gas

CONTRACTOR

Greenland


W. Broadway Pool

Ft. from N. Line

330 Ft. from S. Line

990 Ft. from E. Line

Ft. from W. Line

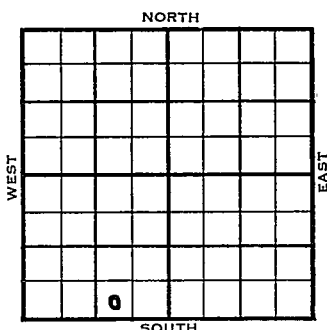

SW SE SW

	ELEVATION	REPORT
1955	1432'	

2/23

Spud 2-17-55
8" @ 197'

3/23

Drlg. 1645'
Spud 2-17-55, gas well, TD 3973
8" @ 197, KC 3031, Miss 3850,
DST 3852-70, open 40 min. gas
in 2 min. 1,450,000 CFG in
10 min. 2,000,000 CFG in 40 min
Rec 240' gassy mud, 1510#
DST 3870-88 open 1 hr gas in
20 min. 125,000 CFG 50' SO &
GCM 120' HO&GCM 60' MO 3' wtr.
1475# DST 3888-3938 open 1 hr
gas in 30 min. 25,000 CFG
540' O&GCM 90' MO 30' wtr.
1425# Miss 3941, TD 3973, 5" @
3971 CO to 3950 40/3922-30
1 1/2 BFPH 3 hr 98% wtr. SP 3916
44/3891-3916 S/1 1/2 BFPH 4 hr
65% oil 250 M-A F/1 BFPH
50% wtr, 2,500,000 CFG
F 50 BOPD 50% wtr.
Comp 2,500,000 CFGPD

COMPLETED


FABEN GILSTRAP

FEB 28 1955

Scout Cards	42
Land Small Map	
Land Wall Map	23
Tracings	
France Map	
Pierce Map	
Misc	

Drig. Data

County Kingman State Kansas
 Sec. 18 (Blk.) 28 (Sur.) 5W Map No.
 Operator Lario Oil & Gas
 Well No. 1 Farm Clouse
 Elev. 1432 Location SW SE SW

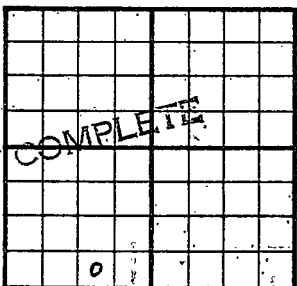

330 Ft. From S Line SW
990 Ft. From E Line Quarter
 1st. Report
 Completion MAR 23 1955
 Remarks W. Broadway Pool
Greenland - Contr.
 Spudding Date 2-17-55

Drig. Data Gas well TD 3973
8" @ 197 KC 3031 Miss. 3850
DST 3852-70 open 40 min. gas in 2 min.
1,450,000 cfg in 10 min. 2,000,000 cfg
in 40 min. Rec. 240' gassy mud 1510#
DST 3870-88 open 1 hr. gas in 20 min.
125,000 cfg 50' so & gcm 120' ho & gcm
60' mo 3' wtr. 1475# DST 3888-3938
open 1 hr. gas in 30 min. 25,000 cfg
540' o & gcm 90' mo 30' wtr. 1425#
Miss. 3941 TD 3973 5" @ 3971
CO to 3950 40/ 3922-30 1 1/2 bfph 3 hr.
98% wtr. SP 3916 .44/ 3891-3916
S/ 1 1/2 bfph 4 hr. 65% oil 250 M-A
F/ 1 bfph 50% wtr. 2,500,000 cfg

FABEN GILSTRAP

Scout Cards	_____
Land Small Map	_____
Land Wall Map	_____
Tracings	_____
France Map	_____
Place Map	_____
Misc.	_____

MAR 31 1955

Comp. 2,500,000 cftpd

F/50 bopd 50% wtr.

Drig. Data