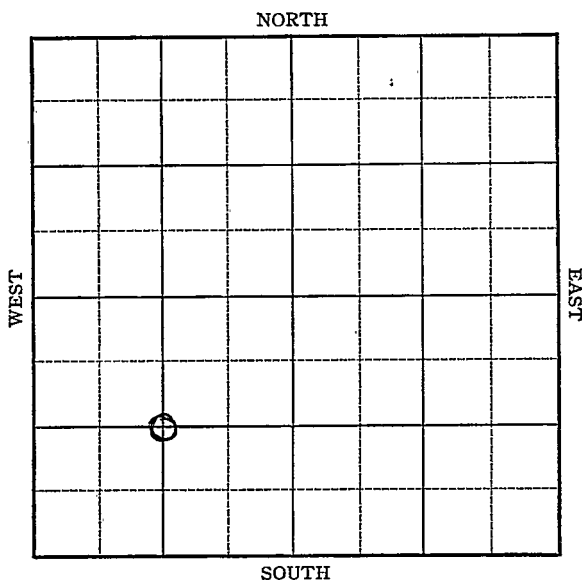
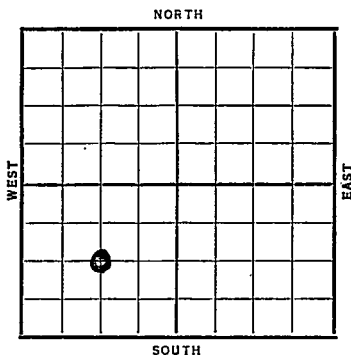


Section 18 Township 28 Range 37-WWell No. 1-18-BurnhamCompany R. K. Wilson

Sec. 18 Twp. 28 R. 37-WWell No. #1 -18- Burnham FarmR. K. Wilson Company Ft. from N. Line1320 Ft. from S. Line Ft. from E. Line1320 Ft. from W. Line*Elev. 3079*

Date

REPORT

1937

11/3

10" @ 530'.

Drilg. 1200'.

11/12

7" @ 2338'. RUST.

11/17

7" @ 2338'.

Sand ?

T.D. 2660'.

120 qts.

6 M gas.

COMPLETED

Grant

KANSAS

Map No. _____ Sec. 18 Twp. 28 R37WWell No. 1 -18- Burnham

R. K. Wilson

Company

Contractor

FIRST REPORT
C SW

_____ Ft. from N. Line

1320 Ft. from S. Line

_____ Ft. from E. Line

1320 Ft. from W. Line

SECTION PLAT

Location _____

Rig up _____

Drilling and Remarks:

10" - 530Drlg. 1200

RECORD

Cased _____ in., _____ ft.

Sand _____

Gas _____

Oil _____

Total Depth _____

PRODUCTION

1st 24 hrs. Nat. _____

1st 24 hrs. after shot _____

Gas _____ Cu. Ft.

Dry Hole _____

Abandoned _____

Date

NOV 3 1937 19

H. D. Hatfield Scout

Grant

KANSAS

Map No. _____ Sec. 18 Twp. 28 R. 37WWell No. 1-18-BurnhamR. K. Wilson Company

Contractor

COMPLETED

C SW

_____ Ft. from N. Line

1320 Ft. from S. Line

_____ Ft. from E. Line

1320 Ft. from W. Line

SECTION PLAT

Location _____

Rig up _____

Drilling and Remarks:

*120 gts**6 M. gas*

RECORD

Cased 7 in., 2338 ft.Sand ?

Gas _____

Oil _____

Total Depth 2660

PRODUCTION

1st 24 hrs. Nat. _____

1st 24 hrs. after shot _____

Gas _____ Cu. Ft.

Dry Hole _____

Abandoned _____

Date

NOV 17 1937 19 H. D. Hatfield Scout