


Section 18 Township 28 Range 38WWell No. #1 BonbrakeCompany Columbian Fuel

NORTH

WEST

EAST

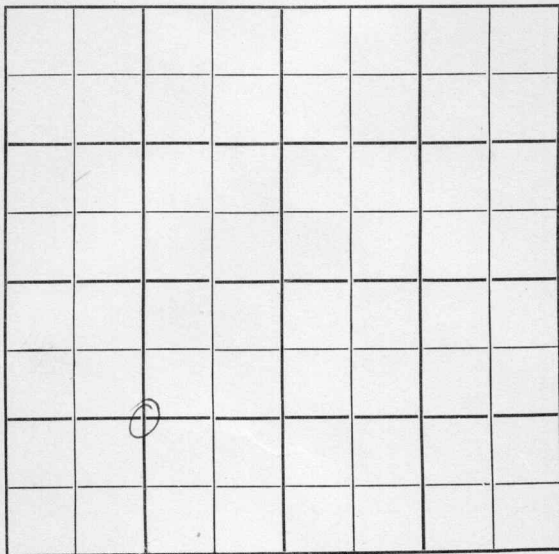

SOUTH

KANSAS

Grant

Sec. 18 Twp. 28 R. 36-W ✓

Well No. #1 Bonebrake Farm

Columbian Fuel Company

Contractor


Ft. from N. Line

1320 Ft. from S. Line

Ft. from E. Line

1420 Ft. from W. Line

C SW

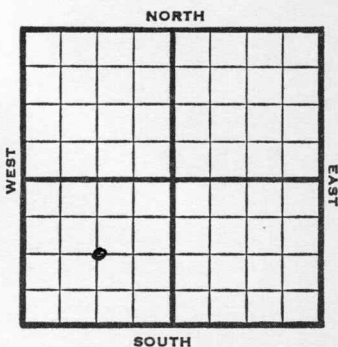

1950 Elev 3033

REPORT

6/7 Spud 5-31-50

10" @ 560

Drlg 1600

7/12 10" @ 560

7" @ 2420

TD 2620

227' of 5" liner

15000 acid total

Her 2421

Win 2474

Comp 14,368,000 gas

Completed

COMPLETED

Krider 2438

Ft Riley 2535

Kansas

Map No. _____ Sec. 18 Twp. 28 R. 36WWell No. 1 BonebrakeColumbian Fuel CompanyC SW Contractor

SECTION PLAT

_____ Ft. from N. Line

1320 Ft. from S. Line

_____ Ft. from E. Line

1420 Ft. from W. LineGrant

Location _____

Rig up _____

Drilling and Remarks:

Spud 5-31-50

10" @ 560

Drlg. 1600

RECORD

Cased _____ in., _____ ft.

Sand _____

Gas _____

Oil _____

Total Depth _____

PRODUCTION

1st 24 hrs. Nat. _____

1st 24 hrs. after shot _____

Gas _____ Cu. Ft.

Dry Hole _____

Abandoned _____

Date

JUN 7 1950 19 J. E. TYRA Scout

Kansas

Map No. _____ Sec. _____ Twp. _____ R. _____

Well No. _____

Company _____

Contractor _____

SECTION PLAT

FIELD REPORT			

Ft. from N. Line _____

Ft. from S. Line _____

Ft. from E. Line _____

Ft. from W. Line _____

RECORD

Cased _____ in _____

Sand _____

Gas _____

Oil _____

Total Depth _____

PRODUCTION

Location _____

Rise up _____

Drilling and Remarks: _____

JUN 12 1950

Scout Cards *EW*

Land Small Map

Land Wall Map *3*

Tracings

France Map

Pierce Map

Misc.

Date

Map No. _____ Sec. 18 Twp. 28 R. 36WWell No. 1 BonebrakeColumbian Fuel

Company


Contractor

C SW/4E1. 3033
SECTION PLAT

_____ Ft. from N. Line

1320 Ft. from S. Line

_____ Ft. from E. Line

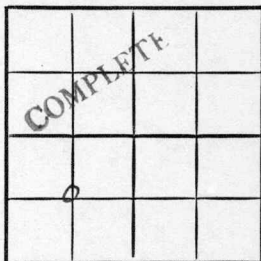1420 Ft. from W. LineGrant County

Location _____

Rig up _____

Drilling and Remarks:

10" @ 5607" @ 2420TD 2620227' of 5" liner15000 acid total**RECORD**

Cased _____ in., _____ ft.

Sand _____

Gas _____

Oil _____

Total Depth 2620**PRODUCTION**

1st 24 hrs. Nat. _____

1st 24 hrs. after shot _____

Gas _____ Cu. Ft.

Dry Hole _____

Abandoned _____

Date

JUL 12 1950 19J. E. TYRA

Scout

11-49

Map No. _____ Sec. _____ Twp. _____ R. _____

Well No. _____

Company _____

Contractor _____

SECTION PLAT



_____ Ft. from N. Line

_____ Ft. from S. Line

_____ Ft. from E. Line

_____ Ft. from W. Line

RECORD

Cased _____ in _____

Sand _____

Gas _____

Oil _____

Total Depth _____

Location _____

Rig up _____

Drilling and Remarks _____

JUL 21 1956

Scout Cards *4 w*

Land Small Map

Land Wall Map *3*

Tracings

France Map

Pierce Map

Misc.

Comp. 14,268

Lt. Riley 2528

Win. 2474

Ryder 2438

Her. 2421

Date