


Section 18 Township 28 Range 35W

Well No. #1 Christopher

Company Columbian Fuel

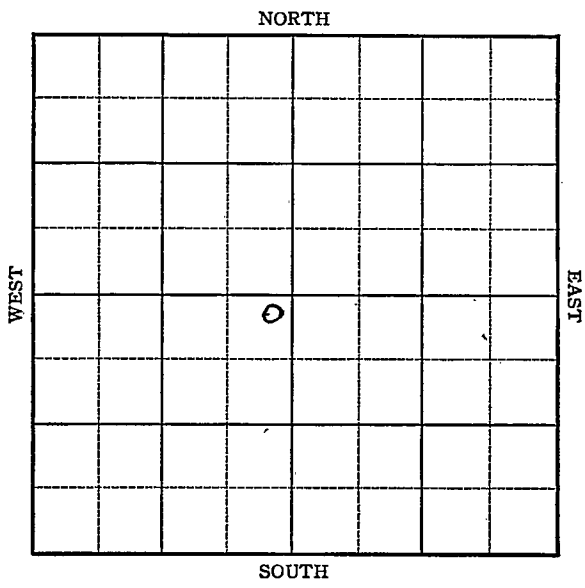

KANSAS Grant County

Sec. 18 Twp. 28 R. 35-W

Well No. #1 Cristopher Farm

Columbian Fuel Company


Hugoton

100 Ft. from N. Line

Ft. from S. Line

100 Ft. from E. Line

Ft. from W. Line

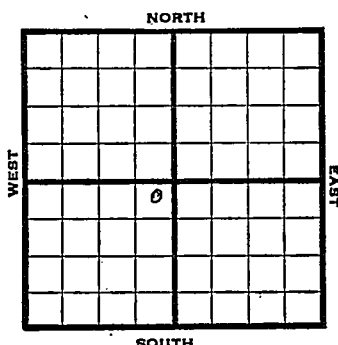

NE SW

1946 Elev. 3085' REPORT

6/19 Location

6/26 RUR

7/3 10" @ 503
Drlg 1620'

7/9 TD 2583'
7" @ 2576 RUST

7/16 " "

7/23 " "

7/30 TD 2765
194' of 5" Perf liner @ 2765'

8/6 " " "

8/13 15000 acid -

8/20 " "

8/27 " "

9/5 " "

9/10 " "

9/18 7" @ 2576'
194' of 5" Perf liner @ 2765'
Acid 15,000
Gas 17,600,000
TD 2765'
RPR 413#

COMPLETED

KANSAS

Kansas Pool Name Hugoton*No map*Map No. _____ Sec. 18 Twp. 28 R. 35WWell No. 1 ChristopherColumbian Fuel

Company _____

FIRST REPORT

Contractor _____

NE SW

SECTION PLAT

100 Ft. from N. Line

	o		

_____ Ft. from S. Line

100 Ft. from E. Line

_____ Ft. from W. Line

Grant County

Location X

Rig up _____

Drilling and Remarks:

RECORD

Cased _____ in., _____ ft.

Sand _____

Gas _____

Oil _____

Total Depth _____

PRODUCTION

1st 24 hrs. Nat. _____

1st 24 hrs. after shot _____

Gas _____ Cu. Ft.

Dry Hole _____

Abandoned _____

Date

JUN 19 1946 19S. J. LEWIS

Scout

KANSAS

Kansas

Pool Name Hugoton PoolMap No. _____ Sec. 18 Twp. 28 R. 35WWell No. 1 ChristopherColumbian Fuel

Company

COMPLETEDNE SW

Contractor

E. J. 385

SECTION PLAT

	6		

100 Ft. from N. Line

_____ Ft. from S. Line

100 Ft. from E. Line

_____ Ft. from W. Line

Grant County

Location _____

Rig up _____

Drilling and Remarks:

7" @ 2576194' 5" Oil finish@ 276515000 Oil17,600,000 Gas413# R₂**RECORD**

Cased _____ in., _____ ft.

Sand _____

Gas _____

Oil _____

Total Depth 2765**PRODUCTION**

1st 24 hrs. Nat. _____

1st 24 hrs. after shot x

Gas _____ Cu. Ft.

Dry Hole _____

Abandoned _____

Date

SEP 1 8 1946

19

S. J. LEWIS

Scout