

Stanton


SECTION 18 TOWNSHIP 28S RANGE 39W CAS

WELL NO. #2 Collingwood "E"

COMPANY Pan American Petr. C E/2 SE

NORTH

~~C SE/4~~

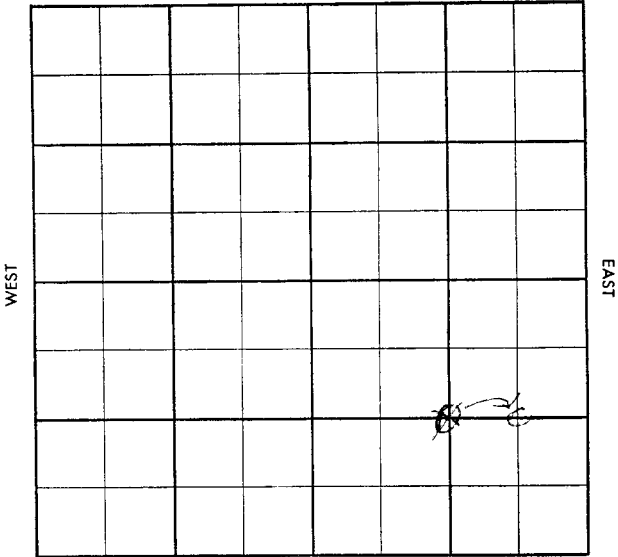

SOUTH

~~Top~~ ~~Pool~~
~~Oil~~ ~~Pool~~

5-513-B

County Stanton Elev. _____
 Sec. 18 Twp. 28 Rge. 39W
 Company Pan American Pet.
 Farm Name Collingwood "E" No. 2

TOPS	DEPTH	LOG	DATUM
Anh.			
Tp.			
H.			
Tr.			
Dg.			
B.L.			
L.			
K.C.			
B.K.C.			
Ce.			
C.			
M.			
M.			
K.			
Mz.			
Mq.			
V.			
S.			
S.			
A.			
R.			
Pf.			
G.			
T.D.			

Loc. in Sec. _____

C SE/4


Geol. _____

Contr. _____

Barbour Tools

Pool _____

Hugoton

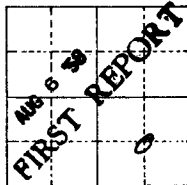

Date Comm. _____

Location - (To be replacement well)

Co.

Ls.

No.

Sec.

T.

R.

CORRECTION

Top ☒ Post ☒
Co ☒ Face ☒

5-513-B

County Stanton Elev 3209 DF
Sec. 18 Twp. 28 Rge. 39W
Company Pan American Pet.
Farm Name Collingwood "E" No. 2

TOPS	DEPTH	LOG	DATUM
Anth. <u>Erid</u>	<u>2274</u>		
Tp. <u>win</u>	<u>2339</u>		
H. <u>Towanda</u>	<u>2390</u>		
Tr. <u>ET Riley</u>	<u>2450</u>		
Dg. <u>Council Grove</u>	<u>2614</u>		
B.L.			
L.			
K.C.			
B.K.C.			
Ce.			
C.			
M.			
M.			
K.			
Mz.			
Mq.			
V.			
S.			
S.			
A.			
R.			
Pf.			
G.			
T.D.	<u>2940</u>		

Loc. in Sec.

~~CSEA~~

~~SESE~~

~~CESE~~

Geol.

Contr.

Barbour Tool

Pool

Hugoton

COMPLETE

27 58

Date Comm. 8-3-58 8" 667/400

Location - To be replacement well AUG 13 58

Council Grove TST

PS T 2568 - 2900 1hr 60'm
all p 0/30" 5" 28 34/700

AUG 20 58 12/2716-18 1/2 TSTM

PB 2600 Blocks 9 C 2475

24/2465-67 24/2423-25

24/2412-14 24/2355-57 24/2300

-02 from 7x7 \$ AUG 27 58 72-20

5.950 MCF SIP 402 PB 2475