


Section 19 Township 28S Range 5W
Well No. #1 Wyer (Byer) ?
Company Greenland Drlg. Co.

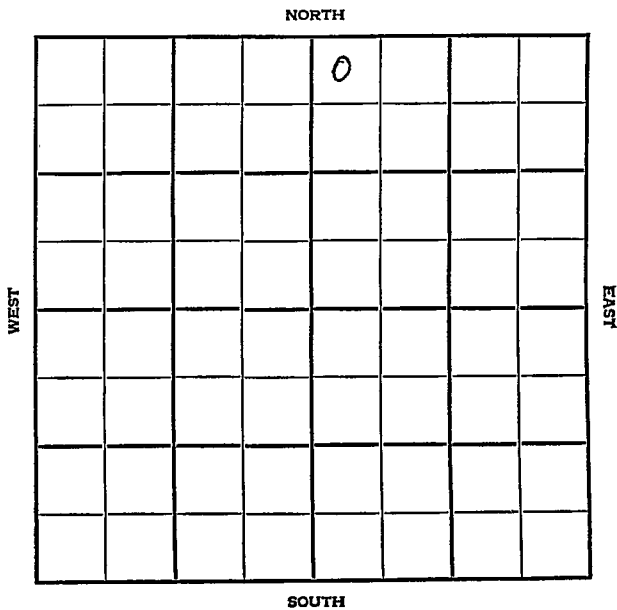

County Kingman State Kansas
 Sec. 19 (Blk. Twp.) 28S (Sur. Rge.) 5W Map No.

Operator Greenland Drig Co.

Well No. 1 Farm Wyer (Byer)?

Elev. Location NW NW NE

FIRST REPORT

330 Ft. From N Line

330 Ft. From W Line NE Quarter
DEC 8 1954

Ist. Report

Completion

Remarks Co. tools

Spudding Date 12-1-54

Drig. Data

Broadway W

8" @ 192 w/175 Drig 2726

FABEN GILSTRAP

County Kingman State KansasSec. 19 (Blk.
Twp.) 28 (Sur.
Rge.) 5W Map No.Operator Greenland Drlg.Well No. 1 Farm WyerElev. 1429 Location NW NW NE

				0		

330 Ft. From N Line NE330 Ft. From W Line Quarter1st. ReportCompletion DEC 15 1954Remarks W. Broadway PoolCo. toolsSpudding Date 12-1-54Drlg. Data D & A TD 39058" @ 192 Br. lime 3006 Lans. 3025Miss. 3859 DST 3865-80 open 1 hr.Rec. 35' mud 0# DST 3880-3905open 1 hr. Rec. 150' mud & 30' wtr.900# TD 3905D & A

FADEN GILSTRAP