

Kingman

DX 78-1

KANSAS

Section 19 Township 28 Range 5W

Well No. #1 Viney

Company Greenland Drig.

NORTH

			0				

WEST

EAST

SOUTH

SEC.	19	TWP.	28	R.	5W
WELL NO.	#1 Viney				
COMPANY	Greenland Drlg.				
CONTRACTOR	Co. Tools.				

Wildcat.


330 Ft. from N. Line

Ft. from S. Line

330 Ft. from E. Line

Ft. from W. Line

NE NE NW

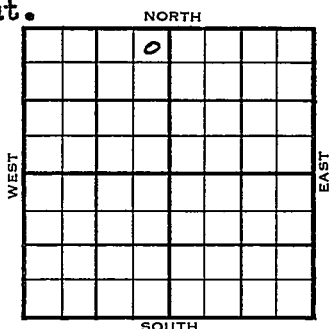

1954

ELEVATION

1429'

REPORT

10/20 Spud 10-16-54

8" @ 215'

Drlg. 1680'

12/22 Spud 10-16-54 Oil well TD 3919
 8" @ 215' Br. line 3004 Lans 3024
 DST 3865-83 open 1 hr gas in 17 min
 rec 55' 0 & GCM, 60' HO & GCM, 60'
 oil, 105' clean oil, 15' wtr. 1170#
 DST 3883-99 open 1 hr gas in 25 min,
 rec 75' 0 & GCM, 360' free oil, 30'
 wtr. 1190# TD 3919 5" @ 3919
 CO to 3895 24/3884-90 FU 150' oil
 1 hr. S/3½ BOPH 4 hr. 1000 A
 S/6 BOPH 6 hr. Miss 3881
 Comp. 127 BOPD 12% wtr.

COMPLETED

County Kingman State Kansas
 Sec. 19 (Blk. Twp.) 28 (Sur. Rge.) 5W Map No. _____
 Operator Greenland Drlg.
 Well No. 1 Farm Viney
 Elev. _____ Location NE NE NW

			0			

330 Ft. From N Line NW330 Ft. From E Line Quarter1st. Report OCT 20 1954

Completion _____

Remarks _____

Co. toolsSpudding Date 10-16-54Wildcat

Drlg. Data

8" @ 215 drlg. 1680

FABEN G. LSTRAP

FABEN CH STRAP