


Section 19 Township 28 Range 38W

Well No. #6 Strat

Company Stanobind

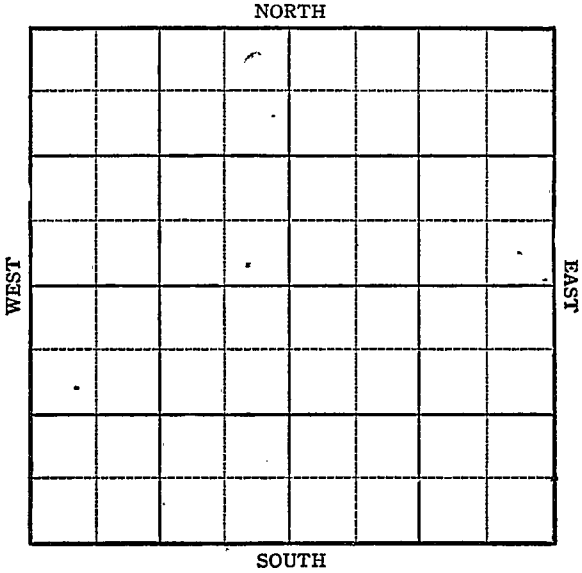

Sec. 19 Twp. 28 R. 38W

Well No. #6 Strat Farm

Stanolind Company


Wildcat

330 Ft. from N. Line

 Ft. from S. Line

330 Ft. from E. Line

 Ft. from W. Line

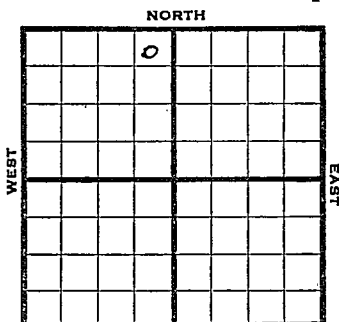

NE NW Elev. 3131 StanolindTH

1945

R E P O R T

| | | |
|------|------------|------|
| 1/17 | Bay Creek | 800 |
| | Blaine | 1145 |
| | Anhy | 1718 |
| | Herrington | 2280 |
| | Krider | 2314 |
| | Winefield | 2371 |
| | Ft Riley | 2433 |
| | B. Flo | 2532 |
| | TD | 2551 |

D & A February 1944

FIRST REPORT

&

ABANDONED

KANSAS

Well Name WildcatMap No. _____ Sec. 19 Twp. 28 R. 38 WWell No. 6 Strat

Stanolind _____ Company

FIRST REPORT

ABANDONED
NE NWE. 17181 Contractor

SECTION PLAT

| | | | |
|--|--|---|--|
| | | o | |
| | | | |
| | | | |
| | | | |

330 Ft. from N. Line

_____ Ft. from S. Line

330 Ft. from E. Line

_____ Ft. from W. Line

Grant

Location _____

Rig up _____

Drilling and Remarks:

Bay Creek 800

Blaine 1145

anhy 1718

herrington 2280

Krider 2314

Winefield 2371

Ft. Riley 2433

B.Flo 2532

F.D. 2551

Date & A February 1944

RECORD

Cased _____ in. _____ ft.

Sand _____

Gas _____

Oil _____

Total Depth 2551

PRODUCTION

1st 24 hrs. Nat. _____

1st 24 hrs. after shot _____

Gas _____ Cu. Ft.

Dry Hole _____

Abandoned _____

JAN 17 1945

19

S. J. LEWIS

Scout