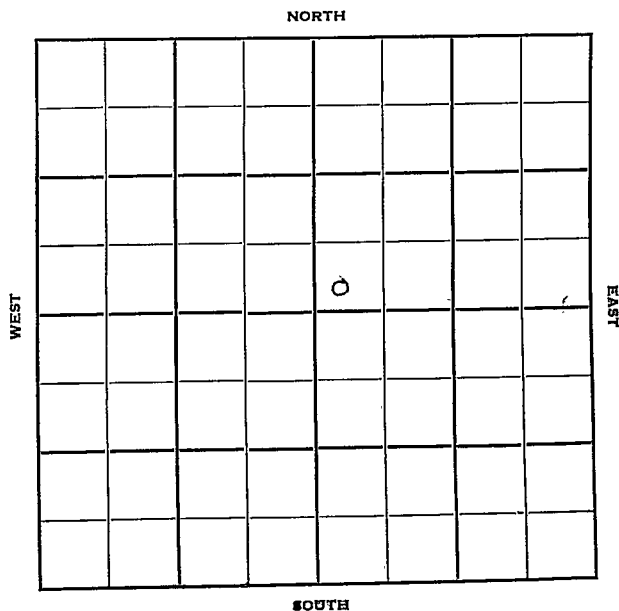


Section 19 Township 28 Range 34-WWell No. #1 FlickCompany Stanolind

Haskell

KANSAS

Sec. 19 Twp. 28 R. 34W

Well No. #1 Flick Farm

Stanolind Company

Contractor

Hugoton Pool


 Ft. from N. Line

150' Ft. from S. Line

 Ft. from E. Line

150' Ft. from W. Line

SW NE

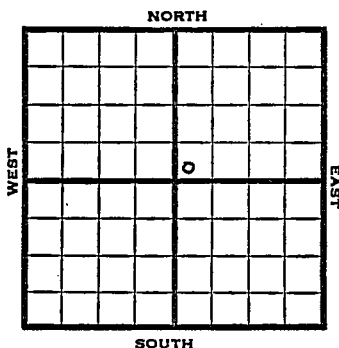

1950

Elev 3036'

REPORT

10/25

Location

12/6

Spud 11-8-50

10" @ 798

7" @ 2805

TD 2825

Her 2621 Win 2700

Towanda 2763 Ft. Riley 2805

132/2626-48, 102/2680-97, 54/2705-14

72/2718-30, 48/2758-66, 66/2771-82

60/2786-96 23000 A


Comp 9,601,000 gas 375#

TD 2825

Completed

COMPLETED

County Haskell State Kansas
 Sec. 19 (Blk.) 28 (Sur.) 34W Map No.
 Operator Stanolind
 Well No. 1 Farm Flick
 Elev. 3036 Location SW NE

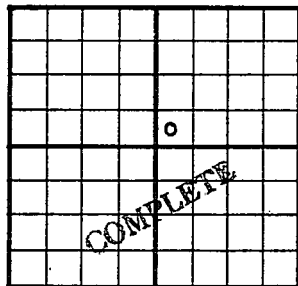

150 Ft. From S Line NE
150 Ft. From W Line Quarter

1st. Report

Completion DEC 6 1950

Remarks Hugoton Pool

Spudding Date 11-8-50

Drlg. Data Gas well TD 2825

10" @ 798 7" @ 2805 TD 2825

Her. 2621 Win. 2700 Towanda 2753

Ft. Riley 2805 132/ 2626-48 102/ 2680-97

54/ 2705-14 72/ 2718-30 48/ 2758-66

66/ 2771-82 60/ 2786-96 23000 A

Comp. 9,601,000 gas 375#