

Section 19 Township 28 Range 39W

Well No. 1 Scherling

Company Stanolind

Hugoton

NORTH

WEST

EAST

				o			

SOUTH

KANSAS Stanton


Sec. 19 Twp. 28 R. 39W

Well No. #1 Scherling Farm
Stanolind Company

Hugoton

150 Ft. from N. Line
150 Ft. from S. Line
150 Ft. from E. Line
150 Ft. from W. Line

SW NE

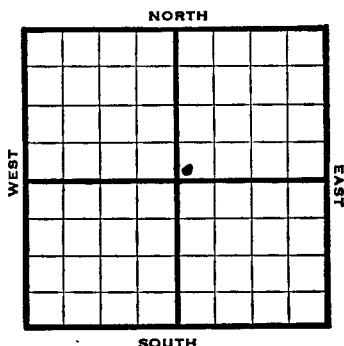

1947 Elev. 3213' REPORT

10/22	Location
10/29	Surface Hole
11/5	10" @ 634' Drig. 2270'
11/12	TD 2270' 7" @ 2260' RUST
11/19	7" @ 2260' 245' of 5" Perf. Liner @ 2560' 17000 Acid 1,500,000 Gas 410# R. Pr. TD 2560'

COMPLETED

Hugoton

Map No. _____ Sec. 19 Twp. 28 R. 39W

Well No. 1 Scherling

Stanolind Company

FIRST REPORT

Contractor

SW NE

SECTION PLAT

		a	

_____ Ft. from N. Line

150 Ft. from S. Line

_____ Ft. from E. Line

150 Ft. from W. Line

Stanton County

Location X

Rig up _____

Drilling and Remarks:

RECORD

Cased _____ in., _____ ft.

Sand _____

Gas _____

Oil _____

Total Depth _____

PRODUCTION

1st 24 hrs. Nat. _____

1st 24 hrs. after shot _____

Gas _____ Cu. Ft.

Dry Hole _____

Abandoned _____

Date

OCT 22 1947 19

S. J. LEWIS

Scout

Map No. Sec. 19 Twp. 28 R. 39W

Well No. 1 Scherling

Stanolind

Company


COMPLETE

Contractor

SW NE

E18213

SECTION PLAT

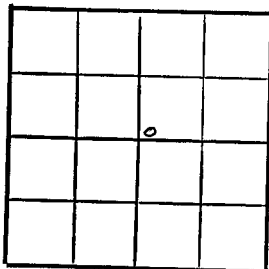

 Ft. from N. Line

150

 Ft. from S. Line

 Ft. from E. Line

150

 Ft. from W. Line

Stanton County

Location

Rig up

Drilling and Remarks:

2" @ 2260

245' of 5" Pay line

@ 2580

17000 @ 2580

1,500,000 Gas

#10 R/A

RECORD

Cased in., ft.

Sand

Gas

Oil

Total Depth 2560

PRODUCTION

1st 24 hrs. Nat.

1st 24 hrs. after shot

Gas Cu. Ft.

Dry Hole

Abandoned

Date

NOV 19 1947

W. J. LEWIS

Scout