
DX 78-1

Kingman KANSAS

Section 2 Township 28 Range 5 W

Well No. 1 Butler

Company B & R Drlg.

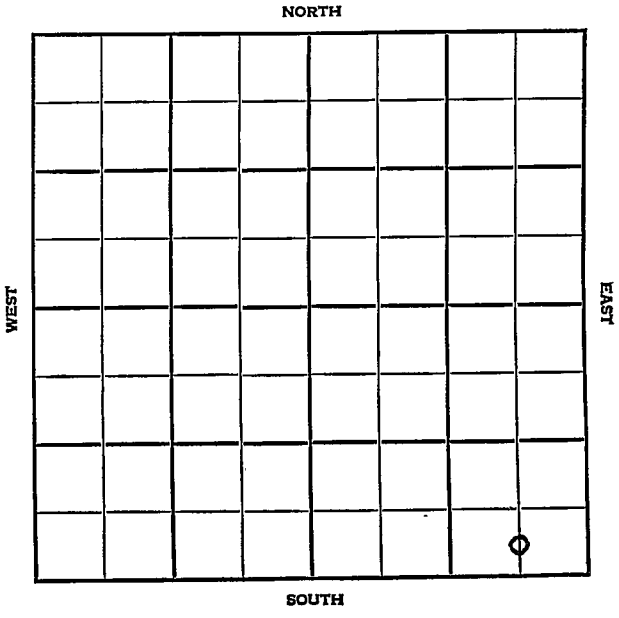

Kingman KANSAS

SEC.	TWP.	R.
2	28	5W

WELL NO. #1 Butler FARM

COMPANY B & R Drlg.

CONTRACTOR Co. Tools.

Casley Pool


_____ Ft. from N. Line

330 Ft. from S. Line

660 Ft. from E. Line

_____ Ft. from W. Line

C S½ SE SE

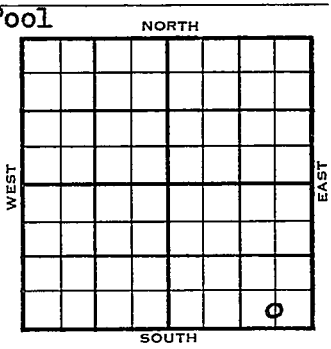

1954	ELEVATION 1411'	REPORT
10/27		R U R
12/15		Oil well TD 3837 Miss 3737 DST 3765-73 open 20 min rec 40' GCM 1200# TD 3837 DST 3780-97 gas in 10 min, op 1 hr. rec 1380' fluid 1300# 5" @ 3837 12/3782-85 F/85 BO 5 hr. Comp. 105 BOPD COMPLETED

DX-78

FORM 275 FOR SALE BY KANSAS BLUE PRINT CO.


County Kingman State Kansas

Sec. 2 (Blk. / Twp.) 28 (Sur. / Rge.) 5W Map No.

Operator B & R Drlg.

Well No. 1 Farm Butler

Elev. Location C S½ SE SE

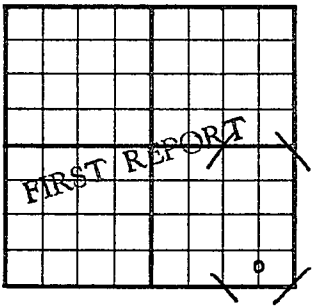

330 Ft. From S Line SE

660 Ft. From E Line Quarter

1st. Report OCT 27 1954

Completion

Remarks Co. tools

Spudding Date

Drlg. Data Casley Pool

R T R

FABEN GILSTRAP

FORM 275 FOR SALE BY KANSAS BLUE PRINT CO.


County Kingman State Kansas

Sec. 2 (Blk. Twp.) 28 (Sur. Rge.) 5W Map No.

Operator B & R Drlg.

Well No. 1 Farm Butler

Elev. 1411 Location C S½ SE SE

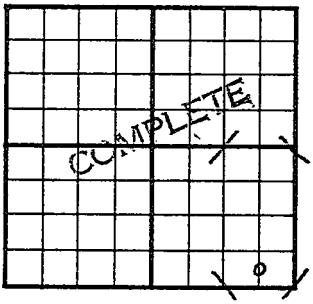

330 Ft. From S Line SE

660 Ft. From E Line Quarter

1st. Report

Completion DEC 15 1954

Remarks Casley Pool

Co. tools

Spudding Date

Drlg. Data Oil well TD 3837

Miss. 3737 DST 3765-73 open 20 min.

Rec. 40' gcm 1200# TD 3837

DST 3780-97 gas in 10 min. open 1 hr.

Rec. 1380' fluid 1300# 5" @ 3837

12/ 3782-85 F/ 85 bo 5 hr.

Comp. 105 bopd

FABEN GILSTRAP