


DX 78-1

Haskell KANSAS

Section 2 Township 28 Range 33W

Well No. 1 Anschutz

Company Northern Natural

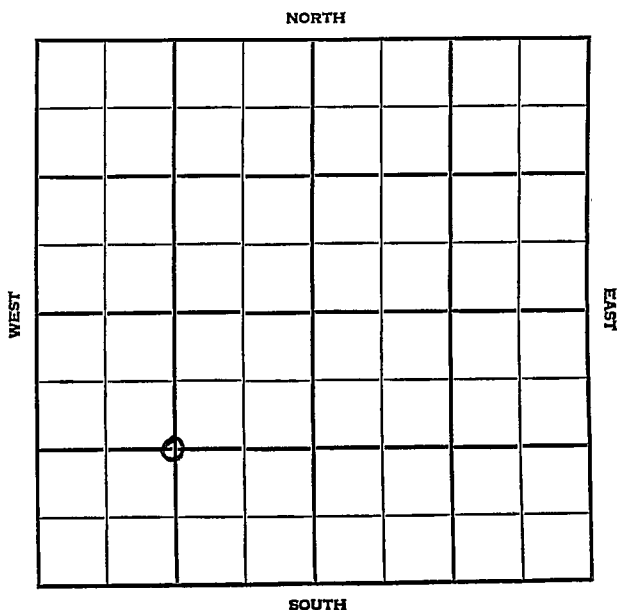

Haskell

KANSAS


SEC.	TWP.	R.
2	28	33W

WELL NO. #1 Anschutz FARM

COMPANY Northern Natural

CONTRACTOR

_____ Ft. from N. Line
 1320 _____ Ft. from S. Line
 _____ Ft. from E. Line
 1320 _____ Ft. from W. Line
 C SW/4

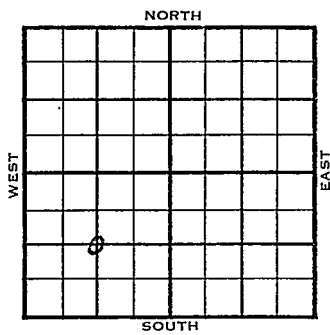

1954	ELEVATION	REPORT
	2983'	

11/17 Spud 11-11-54
 Drlg. 550'

1955
 1/5 Spud 11-11-54 Gas well TD 2801
 10-3/4" @ 558 Hol. 2637' Her. 2680
 Kri. 2735 Win. 2772 TD 2801
 5" @ 2772 GO to 2801 1750 A frac
 4750 A 800,000 CFG 176/2710-54
 1250 A 1,500,000 CFG 1000 A
 frac 4750 A 2,000,000 CFG
 40/2680-90 1750 A frac. 9000 A
 Comp. 6,210,000 CFGPD 375#

COMPLETED

County Haskell State Kansas

Sec. 2 (Blk.) 28 (Sur.) 33W Map No.

Operator Northern Natural

Well No. 1 Farm Anschutz

Elev. _____ Location C SW/4

FIRST REPORT					

1320 Ft. From S Line SW

1320 Ft. From W Line Quarter

1st. Report NOV 17 1954

Completion _____

Remarks _____

Spudding Date 11-11-54

Drlg. Data _____

drlg. 550

FABEN GILSTRAP

County Haskell State Kansas

Sec. 2 (Blk. 28) (Sur. 33W) (Twp.) (Rge.) Map No.

Operator Northern Natural

Well No. 1 Farm Anschutz

Elev. 2983 Location C SW/4

COMPLETE

1320Ft. From S Line SW

1320Ft. From W Line Quarter

1st. Report

Completion JAN 5 1955

Remarks

Spudding Date 11-11-54

Drlg. Data Gas well TD 2801

10 3/4" @ 558 Hol. 2637 Her. 2680

Kri. 2735 Win. 2772 TD 2801 5" @ 2772

CO to 2801 1750 A frac 4750 A

800,000 cfg 176/ 2710-54 1250 A

1,500,000 cfg 1000 A frac 4750 A

2,000,000 cfg 40/ 2680-90 1750 A

frac 9000 A

Comp. 6,210,000 cfgpd 375#

FABEN GILSTRAF