

Ford


FORM 51 25M 3-49 PETROL

KANSAS

Section 2 Township 28 Range 21W

Well No. #1 Bierney (*Birney*)

Company Ruffas Clay et al

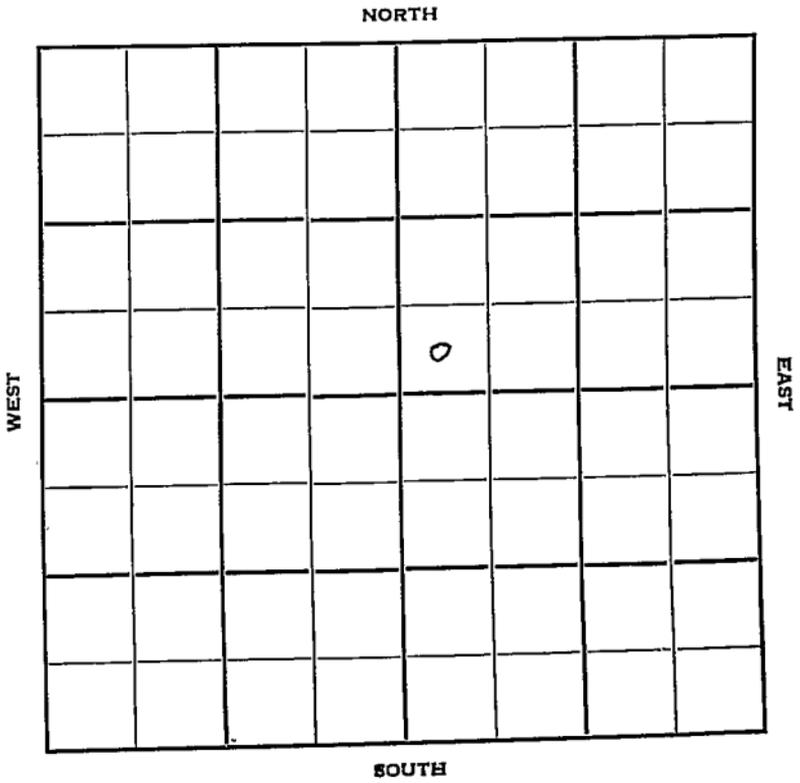

*Handwritten mark*

Sec. 2 Twp. 28 R. 21-W

Well No. #1 Bierbey Farm

Ruffas Clay et al Company

Harber Drlg. Contractor

Wildcat


           Ft. from N. Line

330 Ft. from S. Line

           Ft. from E. Line

330 Ft. from W. Line

SW SW NE

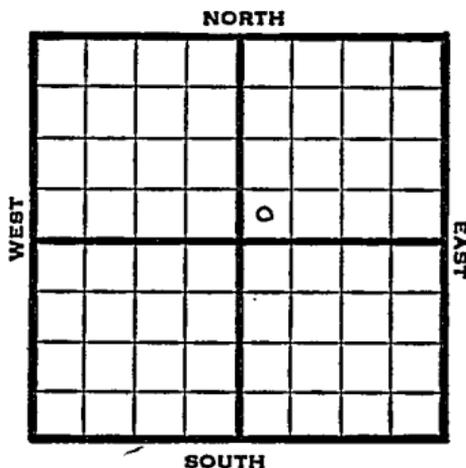

1950 Elev 2338' REPORT

10/4 Location

11/29 Spud 10-5-50  
 13 3/8" @ 320  
 KC 4291  
 DST 4676-5026 opn 1/2 hr test 2,500,900  
 gas rec 350' gcm  
 Miss 4928  
 TD 5045  
 5" @ 5025  
 2000 A  
 S P 5018  
 120/4854-86  
 Est12 mcftpd  
 Comp shut in gas well  
 TD 5045  
 Completed

**COMPLETED**


County Ford State Kansas

Sec. 2 (Blk. Twp.) 28 (Sur. Rge.) 21W Map No.

Operator Ruffas Clay etal.

Well No. 1 Farm Bierney

Elev. \_\_\_\_\_ Location SW SW NE

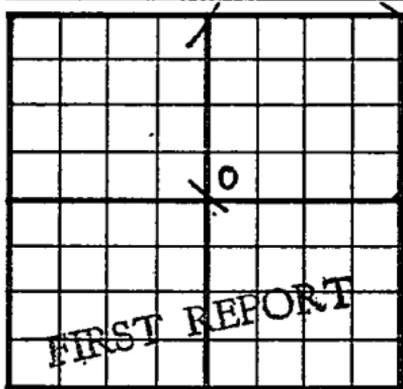

330 Ft. From S Line NE

330 Ft. From W Line Quarter

1st. Report OCT 4 1950

Completion \_\_\_\_\_

Remarks \_\_\_\_\_

Harber Drlg. - Contr.

Spudding Date \_\_\_\_\_

Drlg. Data Wildcat

Location


County Ford State Kansas

Sec. 2 (Blk. Twp.) 28 (Sur. Rge.) 21W Map No.

Operator Ruffas Clay etal.

Well No. 1 Farm Bierney

Elev. 2338 Location SW SW NE

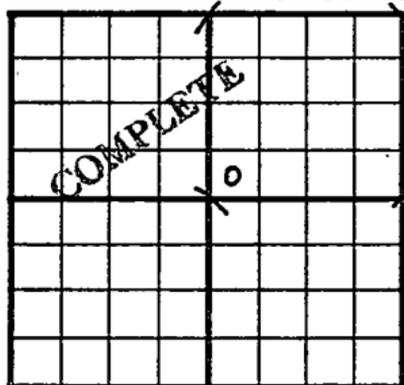

330 Ft. From S Line NE

330 Ft. From W Line Quarter

Ist. Report

Completion NOV 29 1950

Remarks Wildcat

Harbar Drlg. - Contr.

Spudding Date 10-5-50

Drlg. Data Gas well TD 5045

13 3/8" @ 320 KC 4291 DST 4676-5026

open 1/2 hr. test 2,500,000 gas Rec. 350'

gcm Miss. 4928 TD 40 TD 5045 5" @ 5025

2000 A SP 5018 120/4854-86

Est. 12 mcfgpd Comp. shut in gas well

J. E. TYRA