


KANSAS

Stanton

Section 2 Township 28 Range 39-WWell No. 1 Collingwood "C"Company Stanolind

Hugoton Pool

NORTH

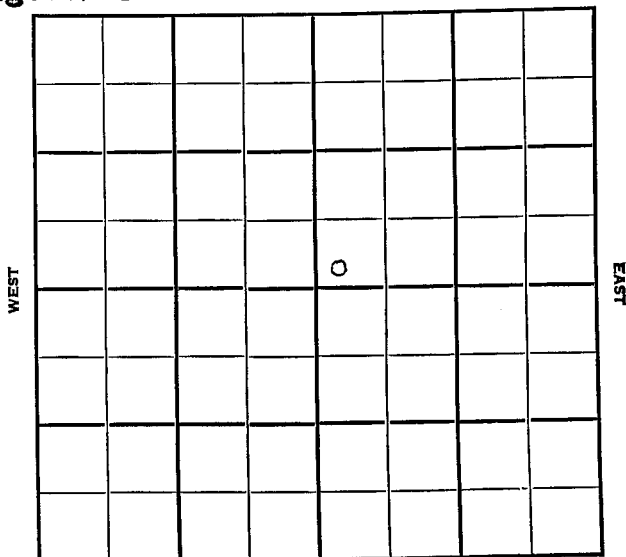

SOUTH

Stanton

Sec. 2 Twp. 28 R. 39W

Well No. #1 Collingwood "C" Farm


Stanolind Company
Hugoton

 Ft. from N. Line

150 Ft. from S. Line

 Ft. from E. Line

150 Ft. from W. Line

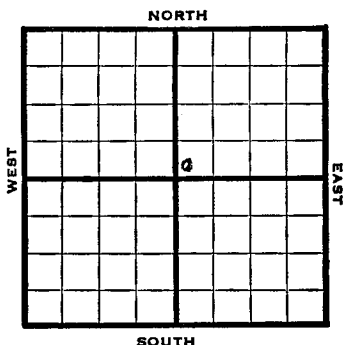

SW NE

1947 Elev. 5149' REPORT

10/8 Location
10/15 "
10/22 9" @ 679'
TD 2315 7" @ 2298'
11/5 7" @ 2298'
226' of 5" Perf liner @ 2519'
Acid 17,000
Gas 8,175,000
Rock Pressure 410#
Total Depth 2519'

COMPLETED

Map No. _____ Sec. 2 Twp. 28 R. 39W

Well No. 1 Collingwood "C"

Stanolind _____ Company

FIRST REPORT _____ Contractor

SW 1/4

SECTION PLAT

		△	

_____ Ft. from N. Line

150 Ft. from S. Line

_____ Ft. from E. Line

150 Ft. from W. Line

Stanton County

Location _____ X _____

Rig up _____

Drilling and Remarks:

RECORD

Cased _____ in., _____ ft.

Sand _____

Gas _____

Oil _____

Total Depth _____

PRODUCTION

1st 24 hrs. Nat. _____

1st 24 hrs. after shot _____

Gas _____ Cu. Ft.

Dry Hole _____

Abandoned _____

Date

OCT 8 1947 19

S. J. LEWIS

Scout

Map No. _____ Sec. 2 Twp. 28 R. 39W

Well No. 1 Collingwood "C"

Stanolind Company

COMPLETE Contractor

SW NE


E1.8149
SECTION PLAT

_____ Ft. from N. Line

150 Ft. from S. Line

_____ Ft. from E. Line

150 Ft. from W. Line

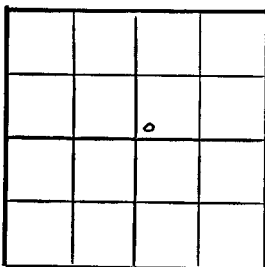

Stanton County

Location _____

Rig up _____

Drilling and Remarks:

7" C2298

226' of 5" Pay liner

C2579

17000 acid

8,125,000 Gall

*410*RA*

RECORD

Cased _____ in., _____ ft.

Sand _____

Gas _____

Oil _____

Total Depth 2518

PRODUCTION

1st 24 hrs. Nat. _____

1st 24 hrs. after shot _____

Gas _____ Cu. Ft.

Dry Hole _____

Abandoned _____

Date

NOV 5 1947 19

S. J. LEWIS

Scout