


Section 2 Township 28 Range 11W

Well Number #1 S.B. Adams

Company Skelly Oil et al

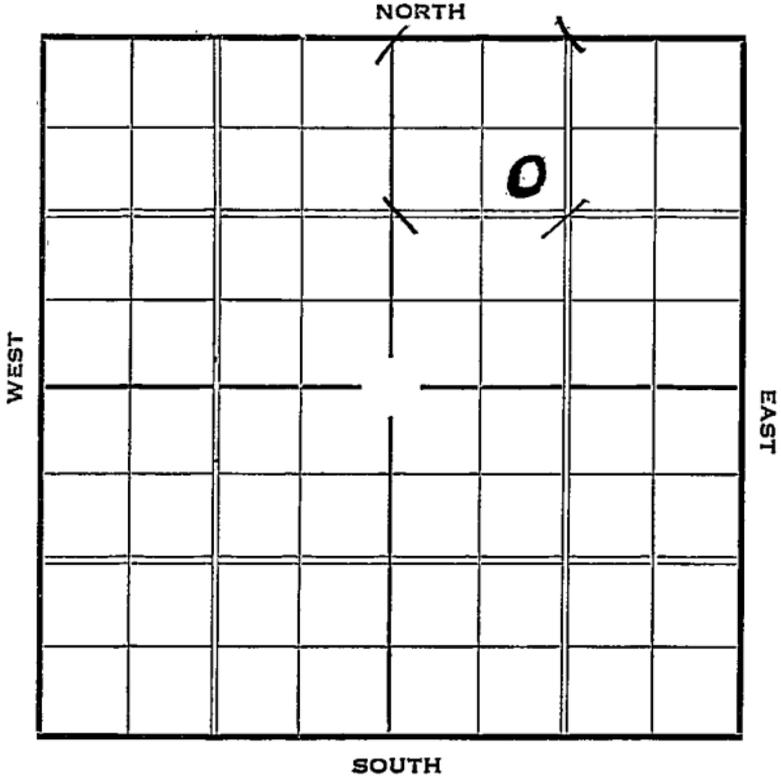

Sec. 2 Twp. 28 R. 11-W

Well No. #1 S.R. Adams Farm

Skelly Oil et al Company


990 Ft. from N. Line

 Ft. from S. Line

 Ft. from E. Line

990 Ft. from W. Line

Elev. 1757

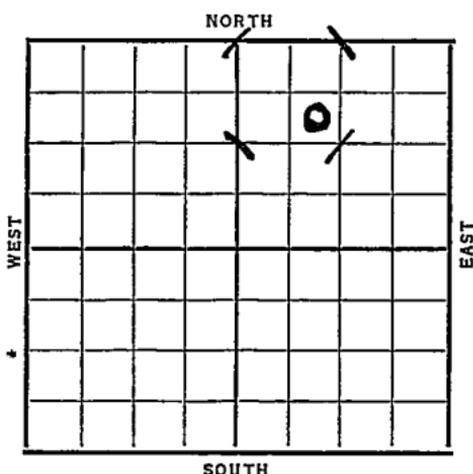

Date	REPORT
1937	
7/7	Location
7/16	R. R.
7/23	R U R
7/30	12" @ 355'. Drlg. 409'.
8/6	Anhy 1450'. Drlg. 2140'.
8/13	Drlg. 3321'.
8/20	Topeka 2983'. K.C. 3537'.
	8" @ 3541'. T.D. 3543'.
	WOC.
8/28	Sm. S.O. 3552-57'.
	½ BW & S.O. 3586-89'.
	Drlg. 3620'.
9/3	3 BW 3658-64'. 1000 water
	3664-3705'. Sm. S.O. 3709-17
9/10	T.D. 3720'. Fsg. SD 3821' repairs.
9/17	Drlg. 3915'.
9/24	T.D. 3957'. Run 6".
10/2	6" @ 3957'. Viola 4172'.
	T.D. 4175' No shows. U.R. 6".

OVER

1937

10/8 Viola 4170'. 7" @ 4177'.
T.D. 4178' S.gas.

10/15 Gas 4178-94'. S.O. 4223-34'.
Drlg. 4270'. 5,853,000 gas.

10/22 S.S.O. 4270-73'. Wilcox 4282'.
H.F.W. 4282-92' T.D.
May plug back.

10/29 T.D. 4300' Fsg.

11/5 " " "

11/12 " " "

11/19 " " "

11/26 " " "

12/3 " " "

12/10 Drlg. by whipstock 4265'.

12/17 P.B. 4204'. WOC.

12/24 P.B. 4200'.

12/31 6000 acid. 23,712,000 gas.

1938

1/5 7" @ 4177'.
Viola 4170'.
T.D. 4300'.
P.B. 4200'.
6000 acid.
43,485,000 gas.
Rock pressure 1325# in 2½ hrs.

COMPLETED

Pratt KANSAS

Map No. 54 Sec. 2 Twp. 28 R. 11 ^W


Well No. 1 - S.B. Adams

Skelly Oil etal Company
 Contractor
Communitized deal

FIRST REPORT

990 Ft. from N. Line
 _____ Ft. from S. Line
 _____ Ft. from E. Line
990 Ft. from W. Line

SECTION PLAT

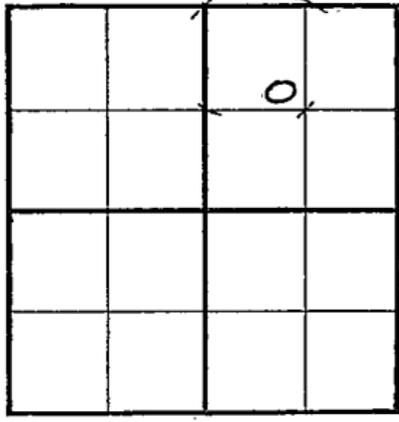

Location ✓
 Rig up _____
 Drilling and Remarks:

RECORD

Cased _____ in., _____ ft.
 Sand _____
 Gas _____
 Oil _____
 Total Depth _____

PRODUCTION

1st 24 hrs. Nat. _____
 1st 24 hrs. after shot _____
 Gas _____ Cu. Ft.
 Dry Hole _____
 Abandoned _____

Date

JUL 7 1937 19

H. D. Hatfield Scout

Handwritten signature

Returned	_____
Cards	_____ <i>Paul</i>
Tracing	_____ <i>John</i>
France Map	_____ <i>Paul</i>
Scarborough Map	_____ <i>Paul</i>
Moody Map	_____ <i>Paul</i>
Scarborough Plat Book	_____
Moody Plat Book	_____

Map No. 54 Sec. 2 Twp. 28 R. 11WWell No. 1 S. B. AdamsSkelly Oil etal _____ Company
(Communitized Deal)
Contractor

COMPLETED

SECTION PLAT

SE NW NE
990 Ft. from N. Line
_____ Ft. from S. Line
_____ Ft. from E. Line
990 Ft. from W. Line

		0	

Location _____

Rig up _____

Drilling and Remarks:

P.B. 4200

6000 acid

43,485,000 gals

Rock Pressure 1325

IN 2 1/2 hrs

RECORD

Cased 7 in., 4177 ft.~~Sand~~ Viola 4170

Gas _____

Oil _____

Total Depth 4300

PRODUCTION

1st 24 hrs. Nat. _____

1st 24 hrs. after shot _____

Gas _____ Cu. Ft.

Dry Hole _____


Abandoned _____

Date

JAN 5 - 1938

19

H. D. Hatfield Scout

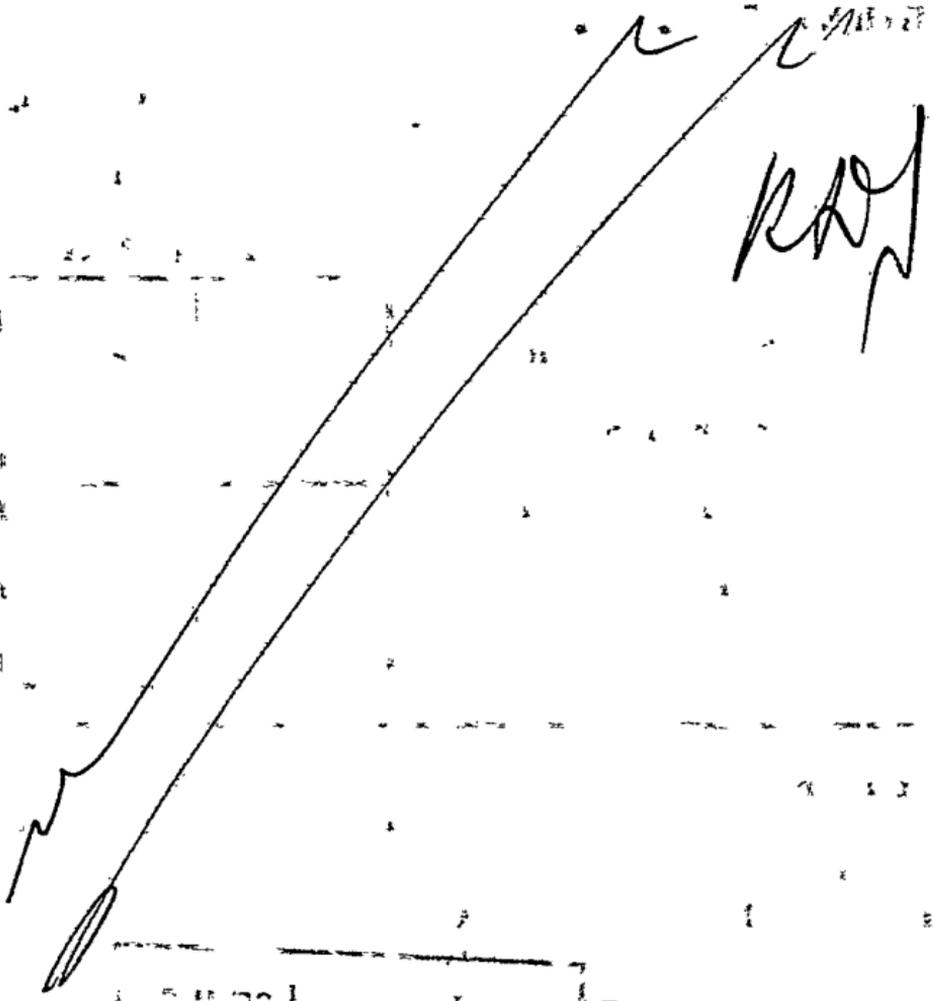

unch
 Paul
 Joe
 KAD
 Local Fiat