

KANSAS

Pratt


Form 51-5M-7-39-Palace

Section 2 Township 28 Range 11-W

Well No. #1 Armistead

Company Skelly et al

NORTH Cunningham Pool

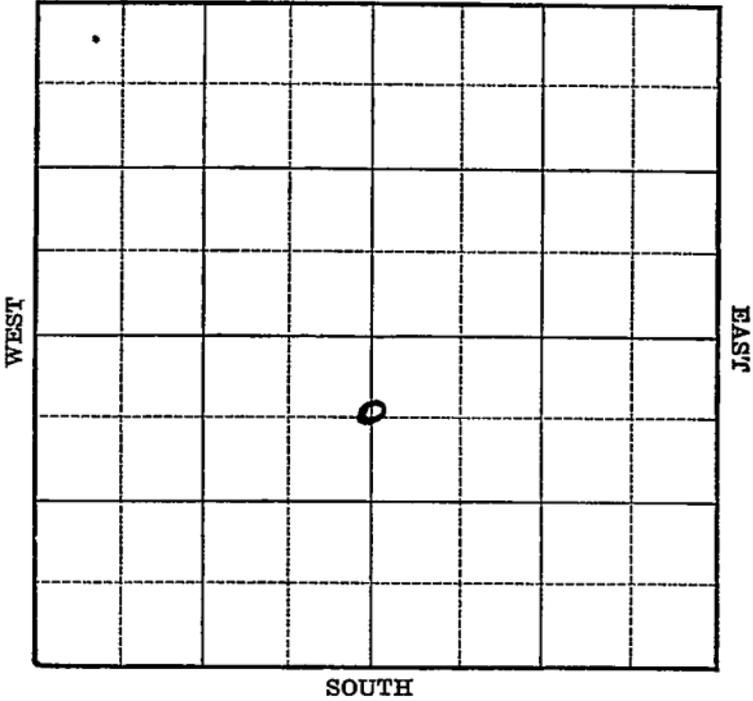

Sec. 2 Twp. 28 R. 11-W

Well No. #1 Armistead Farm

Skelly et al Company

(Cunningham)


670 Ft. from N. Line

_____ Ft. from S. Line

_____ Ft. from E. Line

2666 Ft. from W. Line

Elev. 1746

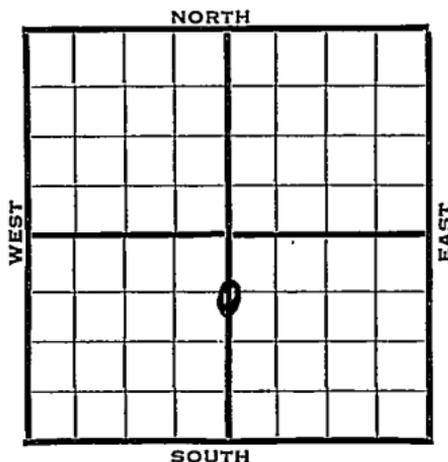

1940	REPORT
6/5	Location
6/13	Derrick.
6/20	8" - 400' WOC.
6/27	Drlg. 3090'
7/3	Drlg. 4095'
7/11	Lansing 3525' Viola 4178-82' TD 5" - 4180½' RUST.
7/18	T.D. 4198' 1000 acid. 24-3/4 M gas.
7/25	" "
8/2	" "
8/8	" "
8/14	" "
8/21	Viola 4178' 5" - 4180½' T.D. 4198' 1000 acid. 28 M cu. ft. gas.
	COMPLETED

Map No. 54 Sec. 2 Twp. 28 R. 11W

Well No. 1 Armistead

Skelly etal Company

Contractor

FIRST REPORT

SECTION PLAT

C $N\frac{1}{2}$ $S\frac{1}{2}$.

670 Ft. from N. Line

_____ Ft. from S. Line

_____ Ft. from E. Line

2666 Ft. from W. Line

		○	

CUNNINGHAM POOL

Location X

Rig up _____

Drilling and Remarks: _____

RECORD

Cased _____ in., _____ ft.

Sand _____

Gas _____

Oil _____

Total Depth _____

PRODUCTION

1st 24 hrs. Nat. _____

1st 24 hrs. after shot _____

Gas _____ Cu. Ft.

Dry Hole _____

Abandoned _____

Date

JUN 5 1940 19

S. J. LEWIS

Scout

Map No. 54 Sec. 2 Twp. 28 R. 11WWell No. 1 ArmisteadSkelly Oil etal Company

Contractor

COMPLETED

SECTION PLAT

C $N\frac{1}{2}$ $S\frac{1}{2}$
670 Ft. from N. Line

_____ Ft. from S. Line

_____ Ft. from E. Line

2666 Ft. from W. Line

CUNNINGHAM POOL

Location _____

Rig up _____

Drilling and Remarks:

Vid 4178
5" @ 4180 1/2
1000 acid
28 M Gas

RECORD

Cased _____ in., _____ ft.

Sand _____

Gas _____

Oil _____

Total Depth 4198

PRODUCTION

1st 24 hrs. Nat. _____

1st 24 hrs. after shot _____

Gas _____ Cu. Ft.

Dry Hole _____

Abandoned _____

Date

AUG 21 1940 19

S. J. LEWIS Scout