

KANSAS

Form 51-5M-7-40-Palace


Pratt

Section 2 Township 28 Range 11-W

Well No. #1 Armitstead "B"

Company Skelly Oil

NORTH Cunningham Pool

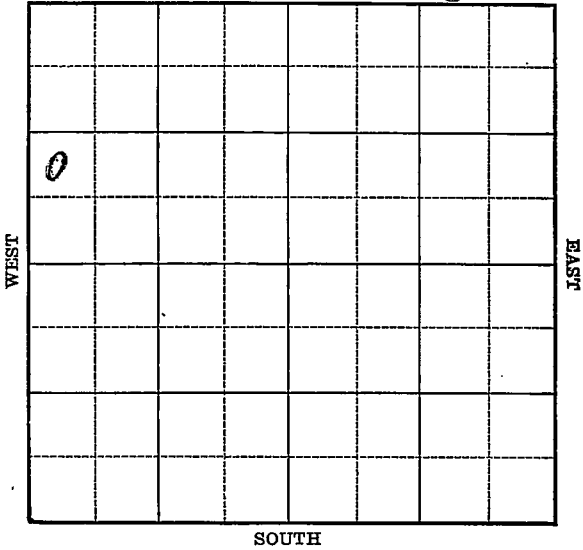

Sec. 2 Twp. 28 R. 11-W

Well No. #1 Armitstead "B" Farm

Skelly Oil Company

(Cunningham)


1659 Ft. from N. Line

_____ Ft. from S. Line

_____ Ft. from E. Line

332 Ft. from W. Line

Elev. 1734

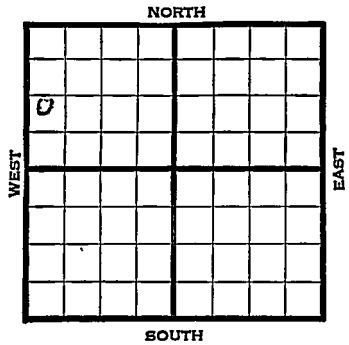

1940	REPORT
10/23	8" - 376' WOC.
10/31	Drlg. 2545'
11/7	Drlg. 4120'
11/14	Lansing 3507' Viola 4162-65' TD 5" - 4163'
11/21	T.D. 4183' 1000 acid. 17-7/10 M gas.
11/27	" " "
12/4	Viola 4162' 5" - 4163'
	T.D. 4183' 1000 acid.
	14 M cu. ft. gas.
	COMPLETED

Map No. 54 Sec. 2 Twp. 28 R. 11WWell No. 1 Armitstead "B"Skelly Oil Company

Contractor

FIRST REPORT

SECTION PLAT

NW SW NW

1659 Ft. from N. Line

_____ Ft. from S. Line

_____ Ft. from E. Line

332 Ft. from W. Line

Cunningham Pool

o			

Location _____

Rig up _____

Drilling and Remarks:

8" - 376 WOC

RECORD

Cased _____ in., _____ ft.

Sand _____

Gas _____

Oil _____

Total Depth _____

PRODUCTION

1st 24 hrs. Nat. _____

1st 24 hrs. after shot _____

Gas _____ Cu. Ft.

Dry Hole _____

Abandoned _____

Date

OCT 23 1940 19

S. J. LEWIS

Scout

Map No. 54 Sec. 2 Twp. 28 R. 11WWell No. 1 Armitstead "B"Skelly Oil Company

Contractor

COMPLETED

NW S'V NW

1659 Ft. from N. Line

_____ Ft. from S. Line

_____ Ft. from E. Line

332 Ft. from W. Line

CUNNINGHAM POOL

SECTION PLAT

o			

Location _____

Rig up _____

Drilling and Remarks:

*Vidla 4162**5" @ 4163**1000 acil**14M Gas***RECORD**

Cased _____ in., _____ ft.

Sand _____

Gas _____

Oil _____

Total Depth 4183**PRODUCTION**

1st 24 hrs. Nat. _____

1st 24 hrs. after shot _____

Gas _____ Cu. Ft.

Dry Hole _____

Abandoned _____

Date

DEC 4 1940

19

S. J. LEWIS Scout