

KANSAS

FORM 51 5M 4-41 PETROL


Pratt

Section 2 Township 28 Range 11-W

Well No. #1 Bowers

Company Drillers Gas

NORTH **C unningham Pool**

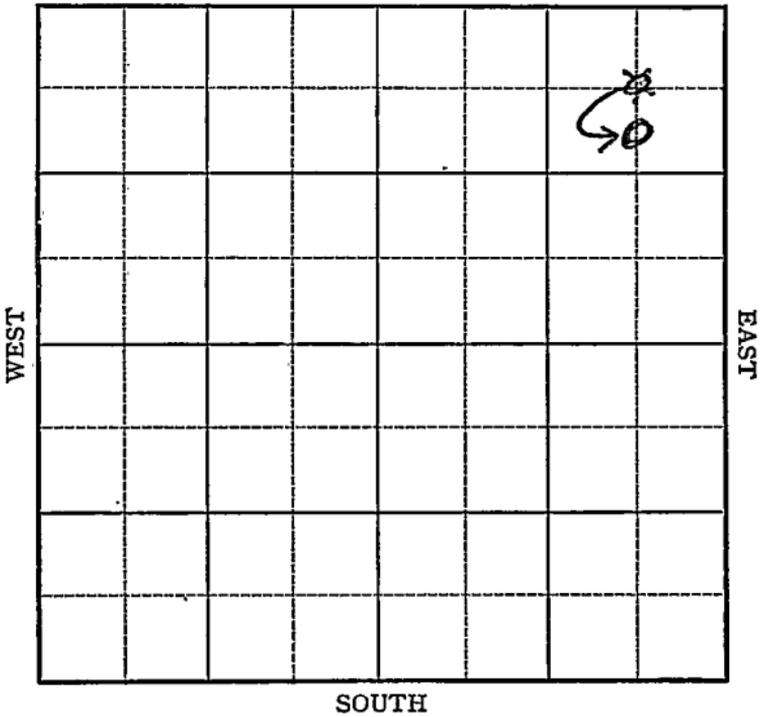

Sec. 2 Twp. 28 R. 11-W

Well No. #1 Bowers Farm

Drillers Gas Company

(Cunningham)


~~660~~ ³⁹⁰ Ft. from N. Line

_____ Ft. from S. Line

660 Ft. from E. Line

_____ Ft. from W. Line

Elev. 1753

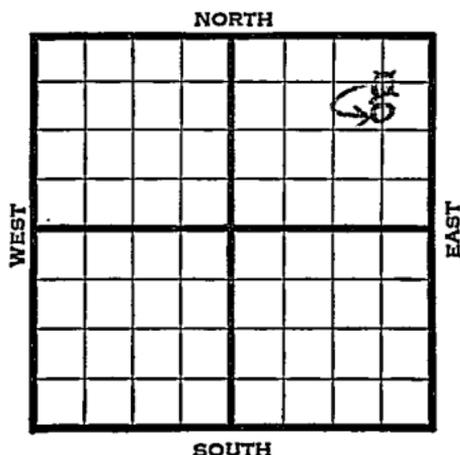

1941

REPORT

4/30 Derrick.

5/8 10" - 422' WOC.

5/15 Drlg. 2750'

5/22 Lans. 3537' Drlg. 4060'

5/28 Viola 4193' 5" - 4195'

T.D. 4217' 7 M gas.

6/5 " " " "

6/12 " " " "

6/18 Viola 4193'

5" - 4195'

T.D. 4217'

1500 acid.

15,372,000 gas.

892# rock pressure.

COMPLETED

Map No. 54 Sec. 2 Twp. 28 R. 11WWell No. 1 BowersDrillers Gas Company

Contractor

FIRST REPORT

SECTION PLAT

660 ^{C NE NE}
Ft. from N. Line

Ft. from S. Line

660 Ft. from E. Line

Ft. from W. Line

CUNNINGHAM POOL

			o

Location _____

Rig up _____

Drilling and Remarks:

Derrick

RECORD

Cased _____ in., _____ ft.

Sand _____

Gas _____

Oil _____

Total Depth _____

PRODUCTION

1st 24 hrs. Nat. _____

1st 24 hrs. after shot _____

Gas _____ Cu. Ft.

Dry Hole _____

Abandoned _____

Date

APR 30 1941 19

S. J. LEWIS Scout

Map No. 54 Sec. 2 Twp. 28 R. 11W

Well No. 1 Bowers

Drillers Gas Company

CORRECTION Contractor

SECTION PLAT

990 Ft. from N. Line

_____ Ft. from S. Line

660 Ft. from E. Line

_____ Ft. from W. Line

			o

CUNNINGHAM POOL

Location _____

Rig up _____

Drilling and Remarks:

Reported

C NE NE

RECORD

Cased _____ in., _____ ft.

Sand _____

Gas _____

Oil _____

Total Depth _____

PRODUCTION

1st 24 hrs. Nat. _____

1st 24 hrs. after shot _____

Gas _____ Cu. Ft.

Dry Hole _____

Abandoned _____

Date

MAY 7 1941

19

S. J. LEWIS

Scout

Map No. 54 Sec. 2 Twp. 28 R. 11WWell No. 1 Bowers

Drillers Gas _____ Company

Contractor _____

COMPLETED

SECTION PLAT

			6

990 C S L NE NE
Ft. from N. Line

_____ Ft. from S. Line

660 Ft. from E. Line

_____ Ft. from W. Line

CUNNINGHAM POOL

Location _____

Rig up _____

Drilling and Remarks:

*Viola 4193**5" @ 4195.**1500 acd**15,372,000 Gas**592 # Rock Pt*

RECORD

Cased _____ in., _____ ft.

Sand _____

Gas _____

Oil _____

Total Depth 427.

PRODUCTION

1st 24 hrs. Nat. _____

1st 24 hrs. after shot _____

Gas _____ Cu. Ft.

Dry Hole _____

Abandoned _____

Date

JUN 18 1941 19S. J. LEWIS Scout