

KANSAS


Pratt

FORM 51 5M PETROL

Section 2 Township 28 Range 11W

Well No. #1 Fitzsimmons "B"

Company Skelly etal.

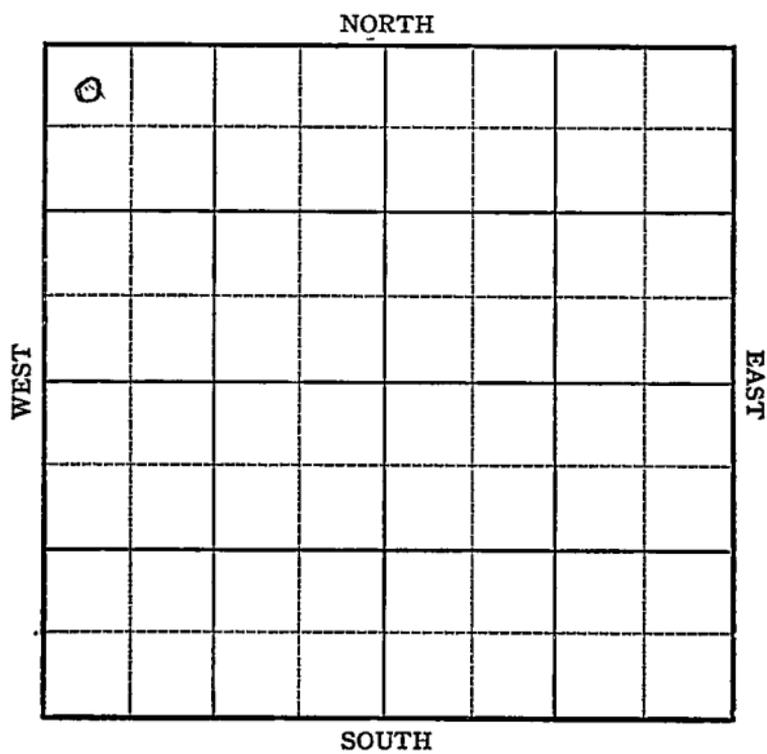

Sec. 2 Twp. 28 R. 11W

Well No. #1 Fitzsimmons "B" Farm

Skelly etal Company

Cunningham


330 Ft. from N. Line

\_\_\_\_\_ Ft. from S. Line

\_\_\_\_\_ Ft. from E. Line

330 Ft. from W. Line

*4/25. 1734*

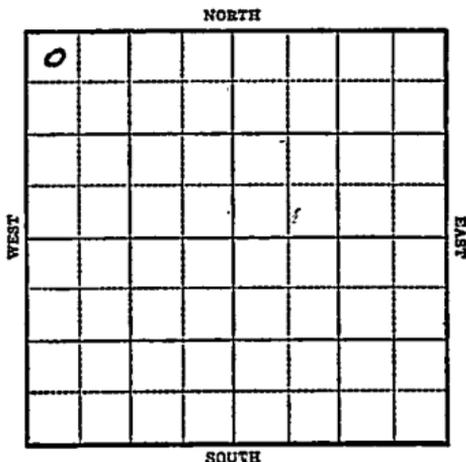

1944

R E P O R T

- 2/16 Location
- 2/23 "
- 3/1 8" @ 380  
WOC.
- 3/8 Drlg. 1650
- 3/16 Drilling 3050
- 3/22 Lans 3491  
TD 3501  
SD 5" @ 3493  
Rust
- 3/29 "
- 4/5 "
- 4/12 TD 3522-1000' oil in 3 hrs.
- 4/19 3000 acid.
- 4/26 " "

**OVER**

1944  
5/8

5" @ 3493  
Lans 3491  
TD 3532  
3000 acid  
Flow 450 Pot  
Gravity 41


COMPLETED

KANSAS

Map No. 54 Sec. 2 Twp. 28 R. 11WWell No. 1 Fitzsimmons "B"Skelly et al. CompanyFIRST REPORT Contractor

NW/C

## SECTION PLAT

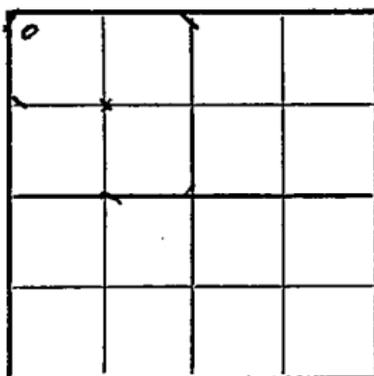330 Ft. from N. Line       Ft. from S. Line       Ft. from E. Line330 Ft. from W. LineCunningham PoolLocation XRig up       

Drilling and Remarks:

## RECORD

Cased        in.,        ft.Sand       Gas       Oil       Total Depth       

## PRODUCTION

1st 24 hrs. Nat.       1st 24 hrs. after shot       Gas        Cu. Ft.Dry Hole       Abandoned       

Date

FEB 16 1944 19S. J. LEWIS Scout

Small Maps

*Osma*

Cards

*Madge*

Tracing

*W. E. G.*

France Map

*[checkmark]*

Scarborough Map

Moody Map

*[checkmark]*

Geological Dept.

Moody Plat Book

**KANSAS**

Pool Name Cunningham

Map No. 54 Sec. 2 Twp. 28 R. 11W

Well No. 1 Fitzsimmons "B"

Skelly et al. Company

**COMPLETED** Contractor

NW/C

**SECTION PLAT**

330 Ft. from N. Line

\_\_\_\_\_ Ft. from S. Line

\_\_\_\_\_ Ft. from E. Line

330 Ft. from W. Line

o			

Pratt County

Location \_\_\_\_\_

Rig up \_\_\_\_\_

Drilling and Remarks:

*Law 3491  
5' @ 3493  
3000 cu ft  
Flow 450. P.D.  
412 gal*

**RECORD**

Cased \_\_\_\_\_ in., \_\_\_\_\_ ft.

Sand \_\_\_\_\_

Gas \_\_\_\_\_

Oil \_\_\_\_\_

Total Depth 3522

**PRODUCTION**

1st 24 hrs. Nat. \_\_\_\_\_

1st 24 hrs. after shot \_\_\_\_\_

Gas \_\_\_\_\_ Cu. Ft.


Dry Hole \_\_\_\_\_

Abandoned \_\_\_\_\_

Date

MAY 3 1944

S. J. LEWIS Scout

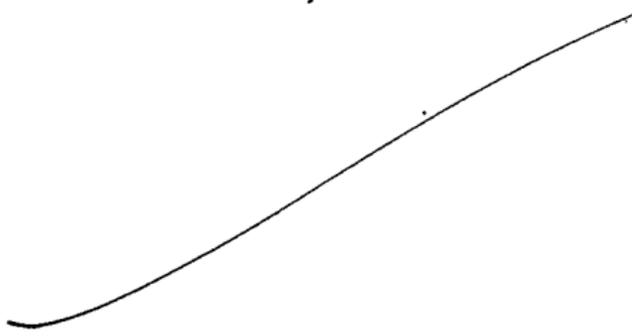

Misc Small Maps	<i>Onna</i>
Cards	<i>Madge</i>
Tracing	<i>Madge</i>
France Map	<i>Madge</i>
Scarborough Map	<i>Madge</i>
Pierce Map	<i>Madge</i>
Geological Dept.	
Pierce Plat Book	