

Sedgwick

KANSAS

SECTION 20 TOWNSHIP 28 RANGE 2 WWELL NO. #1 ZongkerCOMPANY E. K. Carey

NORTH

				0			

WEST

EAST

SOUTH

Sedgwick

KANSAS

SEC. 20	TWP. 2 8	R. 2W
------------	-------------	----------

WELL NO.

#1 Zongker

FARM

COMPANY

E. K. Carey

CONTRACTOR

Co. Tools

WILDCAT


_____ Ft. from N. Line

_____ Ft. from S. Line

_____ Ft. from E. Line

_____ Ft. from W. Line

NW NW NE

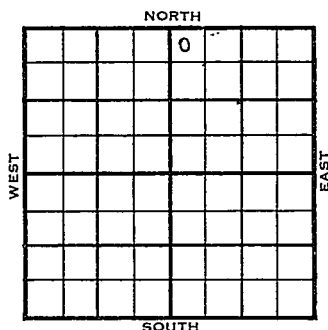

Shell - DHM

1956	ELEVATION	REPORT
------	-----------	--------

2-1

MIR

County Sedgwick Elev. _____
 Sec. 20 Twp. 28 Rge. 2W
 Company E. K. Carey
 Farm Name Zongker No. 1

TOPS	DEPTH	LOG	DATUM	Loc. in Sec.
Anh.				NW NW NE
Tr.				
H.				
Tr.				
Dg.				
Bl.				
L.				
K.C.				Geol.
B.K.C.				Contr.
Ce.				Co. tools
C.				
M.				Pool
M.				Wildcat
K.				
Mz.				
Mq.				
V.				
S.				
S.				
A.				
R.				
PE.				
G.				
T.D.				

Loc. in Sec.

NW NW NE

Geol.

Contr.

Co. tools

Pool

Wildcat

FEB 1 '56

FIRST REPORT

Date Comm.

Shell - DHM

M I R

28