

KANSAS


FORM 51 IOM 12-46 PETROL

Grant county

Section 20 Township 28 Range 38-W

Well No. #1, Fletcher

Company Stanolind O&G

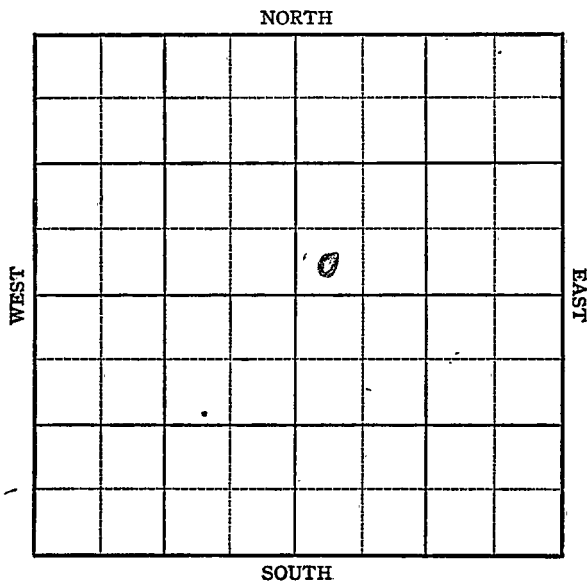

Sec. 20 Twp. 28 R. 38W

Well No. 1 Fletcher Farm

Stanolind Company


Hugoton Pool

Ft. from N. Line

50 Ft. from S. Line

Ft. from E. Line

50 Ft. from W. Line

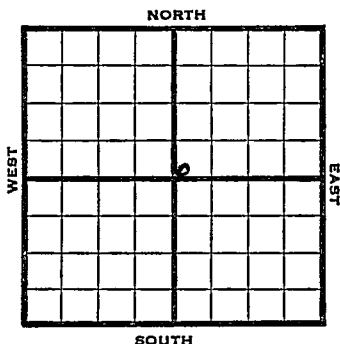

SW NE

1947

Elev. 3121

REPORT

1/2 9" @ 615'
Drlg. 2278'

1/8 TD 2361'
6" @ 2357', RUST

1/15 TD 2560'
15500 Acid

1/21 " "

2/12 6" @ 2357'
15500 Acid
7 M Gas
TD 2560'

COMPLETED

Map No. _____ Sec. 20 Twp. 28 R. 38W

Well No. 1 Fletcher

Stanolind

Company

FIRST REPORT

Contractor

SW NE

SECTION PLAT

		o	

_____ Ft. from N. Line

50 _____ Ft. from S. Line

_____ Ft. from E. Line

50 _____ Ft. from W. Line

Grant County

Location _____

Rig up _____

Drilling and Remarks:

9" @ 615

drlg. 2278

RECORD

Cased _____ in., _____ ft.

Sand _____

Gas _____

Oil _____

Total Depth _____

PRODUCTION

1st 24 hrs. Nat. _____

1st 24 hrs. after shot _____

Gas _____ Cu. Ft.

Dry Hole _____

Abandoned _____

Date

JAN 2 1947 19

S. J. LEWIS

Scout

Map No. _____ Sec. 20 Twp. 28 R. 38W

Well No. 1 Fletcher

Stanolind

Company

COMPLETE

Contractor

SW NE

E1321

SECTION PLAT

		d	

Ft. from N. Line

50

Ft. from S. Line

Ft. from E. Line

50

Ft. from W. Line

Grant County

Location _____

Rig up _____

Drilling and Remarks:

6 "C 2357


7M Gas

REGORD

Cased _____ in., _____ ft.

Sand _____

Gas _____

Oil _____

Total Depth 2560

PRODUCTION

1st 24 hrs. Nat. _____

1st 24 hrs. after shot _____

Gas _____ Cu. Ft.

Dry Hole _____

Abandoned _____

Date

FEB 12 1947 19

S. J. LEWIS

Scout