


Section 20 Township 28 Range 33W

Well No. #1 Onions

Company Northern Natural

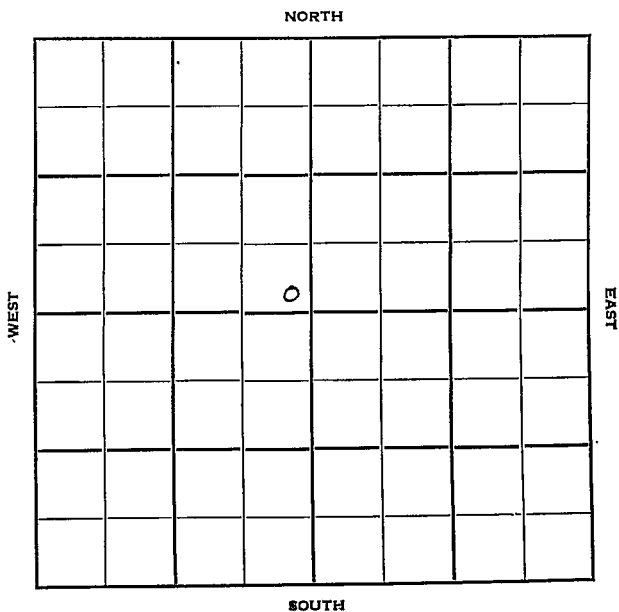

Sec. 20 Twp. 28 R. 33W

Well No. #1 Onions Farm

Northern Natural Company

Hugoton Pool Contractor


         Ft. from N. Line

200' Ft. from S. Line

200' Ft. from E. Line

         Ft. from W. Line

SE NW

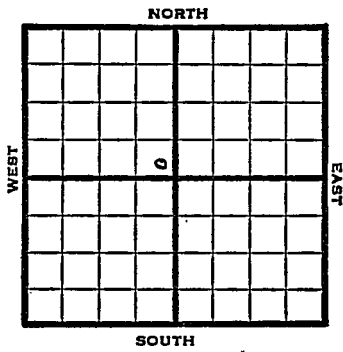

1950

Elev 2981 REPORT

6/21 Spud 6-18-50  
10" @ 549'  
WOC

8/2 10" @ 549 7" @ 2550 TD 2757  
Her 2608 Krider 2664  
Win 2714  
30,000 total acid  
Comp. 15,276,000 gas 374#  
Completed

**COMPLETED**

Map No. \_\_\_\_\_ Sec. 20 Twp. 28 R. 33WWell No. 1 Onions

Northern Natural \_\_\_\_\_ Company

Moran \_\_\_\_\_ Contractor

SE NW

## SECTION PLAT


o

FIRST REPORT

\_\_\_\_\_ Ft. from N. Line

200 Ft. from S. Line200 Ft. from E. Line

\_\_\_\_\_ Ft. from W. Line

Haskell County

Location \_\_\_\_\_

Rig up \_\_\_\_\_

Drilling and Remarks:

Spud 6-18-50

10" @ 549

WOC

## RECORD

Cased \_\_\_\_\_ in., \_\_\_\_\_ ft.

Sand \_\_\_\_\_

Gas \_\_\_\_\_

Oil \_\_\_\_\_

Total Depth \_\_\_\_\_

## PRODUCTION

1st 24 hrs. Nat. \_\_\_\_\_

1st 24 hrs. after shot \_\_\_\_\_

Gas \_\_\_\_\_ Cu. Ft.

Dry Hole \_\_\_\_\_

Abandoned \_\_\_\_\_

Date

JUN 21 1950 19 J. E. TYRA Scout

