


Kiowa

KANSAS

SECTION 20 TOWNSHIP 28 RANGE 19W

WELL NO. #1 McElwain

COMPANY E.K. Carey

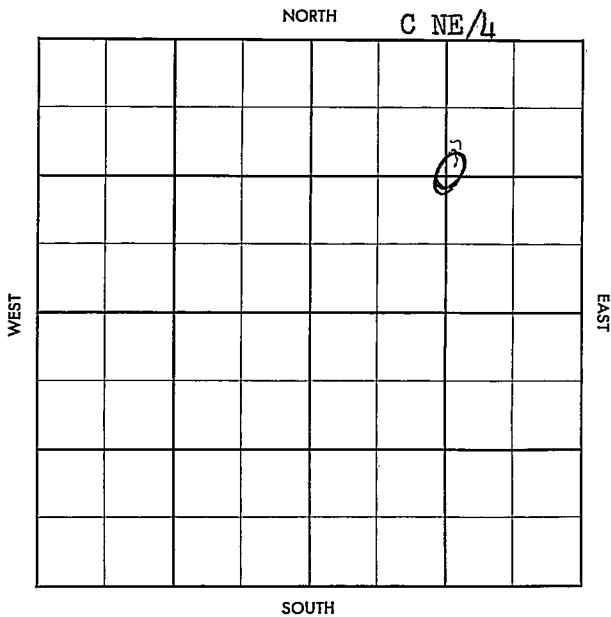

FORM 513 SUNRAY

County Kiowa

Elev

Sec. 20

Type

28

Page

7.9W

Company E. K. Carey

Farm Name McElwain

No. 7

TOPS	DEPTH	LOG	DATUM
Anh			
TP			
H.			
Tr.			
Dg.			
BL			
L.			
K.C.			
B.K.C.			
Ce.			
C.			
M.			
M.			
K.			
Mz.			
Mq.			
V.			
S.			
S.			
A			
R.			
PE.			
G.			
T.D.			

Loc. in Sec.

C ME/1:

Geol.

Contr.

Prime Drfg.

Pool

Wildcat.

4
FIRST REPORT
SEP 4 57

Date Comm.

Location

125

FORM 513 SUNRAY

County Kiowa

Elev. _____

Sec. 20Twp. 28Rgs. 19WCompany E. K. CareyFarm Name McElwainNo. 1

TOPS	DEPTH	LOG	DATUM	Loc. in Sec.
Anb.				C NE/4
Tr.				
H.				
Tr.				
Dg.				
Bl.				
L.				
K.C.	4292			Geol.
B.K.C.				Contr.
Ce.				Prime Drlg.
C.				
M.	4907			Pool
M.				Wildcat
K.				
Mz.				
Ma.				
V.				
S.				
S.				
A.				
R.				
Pe.				
G.				
T.D.	5060			

DEC 11 57	
COMPLETE	

Date Comm. _____

Location SEP 11 57 9-6-57 8 1/2 440/275

17 2495 SEP 18 57 17 4540

SEP 25 57 DST 4904-18 140

6 1/4" GA 228 MCF per 120'

W CM. BHP 1480 DST 4919-29

75" G 1/1" GA 312 MCF/10" per

90' GCO +40 W BHP 1605

DST 4929-38 10' M no

PR 1.5 T 4923-38 2 1/2 hrs

6/4" SA 295 MCF/10" 600 MCF
 24 hrs Acc 220' @ 6 MCO
 +15' w BHP 1605 DST 4939-75
 1 hr Acc 220' mdy w BHP 1595
 5¹/₂ 5059/75 WOC + OCT 2 '57
 OCT 9 '57 20/4925-30 500A
 600 MCF 20/4920-25 OCT 15 '57
 Frac 2.500 MCF +25
 BW ph OCT 23 '57 OCT 30 '57 NOV 6 '57
 NOV 20 '57 2: '57 DEC 4 '57 DEC 11 '57

51 gas well

2.500 mcf +25 BW ph
 1/2" chlk