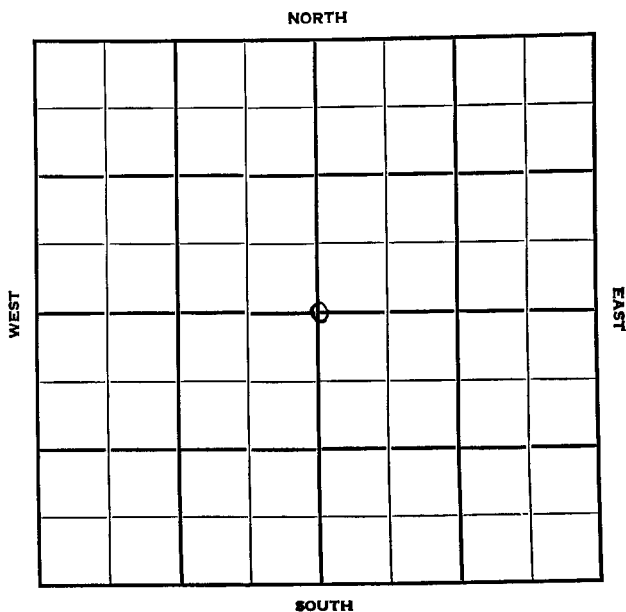


Section 20 Township 28 Range 39NWell No. #1 WelchCompany Stanolind

Sec. 20 **KANSAS** Twp. 28 R. 39W ✓

Well No. #1 Welch Farm

Stanolind

Company

Hugoton Pool


2640' Ft. from N. Line

Ft. from S. Line

2640' Ft. from E. Line

Ft. from W. Line

C Sec.

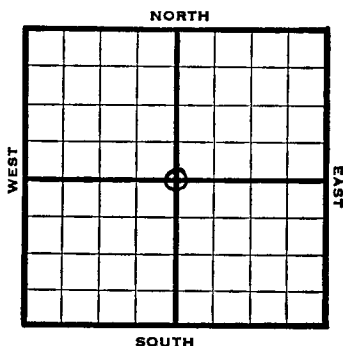

1948 Elev. 3184' REPORT

2/4 Location

2/11 "

2/18 8" @ 598'
Drlg 1845'

2/25 TD 2252'
7" @ 2250'

3/3 RUST
TD 2475'

228 of 5" Perf liner @ 2475
16,500 acid

3/10 "

3/17 "

3/24 "

3/31 "

4/7 7" @ 2250'
228' of 5" Perf liner @ 2475'
Acid 16,500
Gas 6,630,000
R. Pr. 432#
TD 2475'

COMPLETED

Map No. _____ Sec. 20 Twp. 28 R. 39W

Well No. 1 Welch

Stanolind Company

FIRST REPORT Contractor

C Sec.


SECTION PLAT

2640 Ft. from N. Line

_____ Ft. from S. Line

2640 Ft. from E. Line

_____ Ft. from W. Line

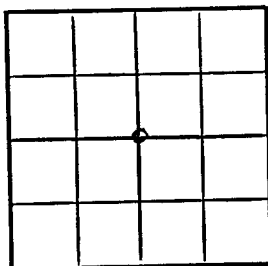

Stanton Ccounty

RECORD

Location X

Cased _____ in., _____ ft.

Rig up _____

Sand _____

Drilling and Remarks:

Gas _____

Oil _____

Total Depth _____

PRODUCTION

1st 24 hrs. Nat. _____

1st 24 hrs. after shot _____

Gas _____ Cu. Ft.

Dry Hole _____

Abandoned _____

Date

FEB 4 1948 19

S. J. LEWIS Scout

Map No. _____ Sec. 20 Twp. 28 R. 39W

Well No. 1 Welch

Stanolind

Company

COMPLETE

Contractor

C Sec.


E13184
SECTION PLAT

2640 Ft. from N. Line

_____ Ft. from S. Line

2640 Ft. from E. Line

_____ Ft. from W. Line

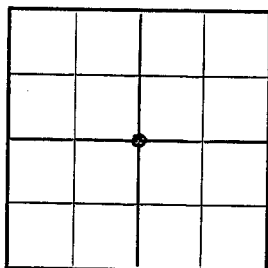

Stanton County

Location _____

Rig up _____

Drilling and Remarks:

7" @ 2250

228' x 5" Pipe line

@ 2475

165000000 C

6,630 000 Gas

432 * RE

RECORD

Cased _____ in., _____ ft.

Sand _____

Gas _____

Oil _____

Total Depth 2475

PRODUCTION

1st 24 hrs. Nat. _____

1st 24 hrs. after shot _____

Gas _____ Cu. Ft.

Dry Hole _____

Abandoned _____

Date

APR 7 1948 19 S. J. LEWIS Scout