


Section 20 Township 28 Range 16W

Well No. #1 Heath

Company Southerwestern Explr.

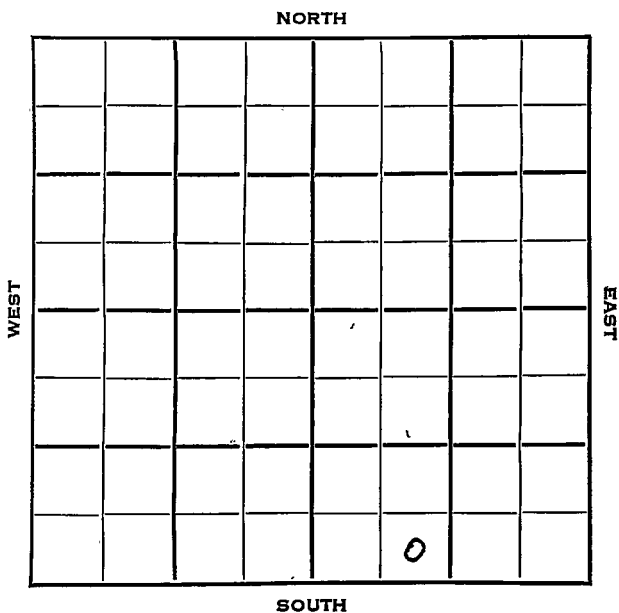

SEC.	TWP.	R.
20	28	16W

WELL NO. #1 Heath FARM

COMPANY Southwestern Expl.

CONTRACTOR G-M-R


Wildcat

_____ Ft. from N. Line

330 _____ Ft. from S. Line

_____ Ft. from E. Line

990 _____ Ft. from W. Line

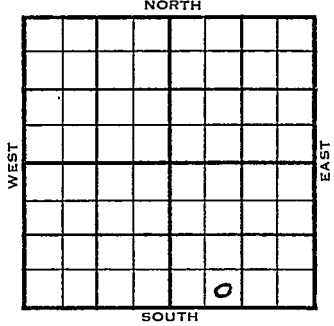


SE SW SE
Sinclair acreage & DHM

	ELEVATION	REPORT
1953	2175'	
9/2	Spud 8-26-53 8" @ 345' Drlg 2881'	
9/9	Br li 4209' Lans 4224' Drlg. 4519'	
9/16	Spud 8-26-53 D & A TD 5092' 8" @ 345' Top. 3627', Br. Lime 4209', Lans 4224, Miss 4743, DST 4756-70 opn 1 hr, rec 25' mud 1100# DST 4747-55 opn 1 hr, rec 30' mud, 780# Kh. 4819' DST 4820-46 opn 1/2 hr, rec 10' mud 75# Viola 4852, Simp 4985, Arb 5058 TD 5092' D & A	

ABANDONED

County Kiowa State Kansas
 Sec. 20 (Blk.) 28 (Sur.) 16W Map No. (Twp.) (Rge.)
 Operator Southwestern Expl.
 Well No. I Farm Heath
 Elev. 2175 Location SE SW SE

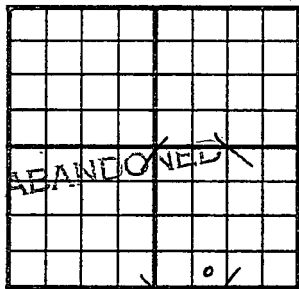

330Ft. From S Line SE
990Ft. From W Line Quarter
 1st. Report _____
 Completion SEP 16 1953
 Remarks Wildcat
G-M-R - Contr.
 Spudding Date 8-26-53

Drlg. Data D & A TD 5092
8" @ 345 Top. 3627 Br. lime 4209
Lans. 4224 Miss. 4743 DST 4756-70
open 1 hr. Rec. 25' mud 1100#
DST 4747-55 open 1 hr. Rec. 30' mud
780# Kh. 4819 DST 4820-46 open 1/2 hr.
Rec. 10' mud 75# Viola 4852
Simp. 4985 Arb. 5058 TD 5092

D & A

J. G. McGEHEE