



Sec. 20 Twp. 28 R. 9-W


Well No. #1 Darlington Farm  
Plains Exploration Company  
Pat Creek Pool

         Ft. from N. Line

990 Ft. from S. Line

~~330~~ Ft. from E. Line

990 Ft. from W. Line

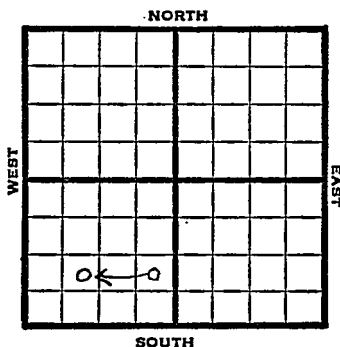

SW  
NE ~~SE~~ SW

1947 Elev. 1725 REPORT

- 3/21 R U R
- 4/2 8" @ 281  
Anhy. 455 Drlg. 2489'
- 4/9 Lansing 3590'  
Drlg. 4004'
- 4/15 Mississippi 4130'  
Viola 4407'  
TD 4410'  
Run csg.
- 4/23 5" @ 4408'  
RUST
- 4/29 5" @ 4413'  
Viola 4412  
Corrected  
TD 4416'  
Flow 33 bbls oil PH 2 hrs
- 5/7 " " "
- 5/13 " " "
- 5/20 Flow 29 fluid  
PH 8% water

OVER

5/28 Viola 4412  
5" @ 4413  
Bonnet Pot  
3000  
Grav. 39  
TD 4416'

COMPLETED

O.W.W.O.

1952

9/24 Viola 4412' OTD 4416  
5" @ 4413'  
DD 4440'  
10/1 NR  
10/8 "  
10/15 "  
10/22 DD Simp. sd 4498-4519'  
TD 4523' Ran log.  
10/29 Sch Tops: Miss 4133', KH 4209', Chat  
4384', V. 4413', Simp shale 4473',  
Simp sd 4495'  
11/5 NR  
11/12 NR  
11/20 "  
11/27 "  
12/4 "  
12/11 NR  
12/18 NR  
12/25 NR  
1/1 NR  
1/8 NR

1953

1/14 OilWell TD 4523  
Viola 4412 OTD 4416  
5" @ 4413 DD 4440  
Simp sd 4498-4519  
TD 4523  
Miss 4133, Kh 4209, Chat 4384,  
Viola 4413, Simp sh 4473, Simp  
sd 4495  
37/4501-09½ wtr PB 4503½  
12/4495-99  
Comp. 50 bopd 10% wtr

COMPLETED

Map No. K36 Sec. 20 Twp. 28 R. 9W

Well No. 1 Darlington


Plains Exploration Company

**CORRECTION**

Contractor

NE SW SW

SECTION PLAT

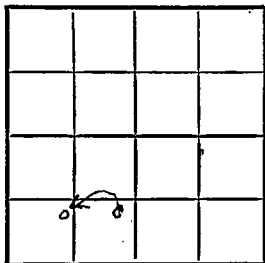

\_\_\_\_\_ Ft. from N. Line

990 Ft. from S. Line

\_\_\_\_\_ Ft. from E. Line

990 Ft. from W. Line

Kingman County

Location \_\_\_\_\_

Rig up \_\_\_\_\_

Drilling and Remarks: \_\_\_\_\_

Reported

NE SE SW

RECORD

Cased \_\_\_\_\_ in., \_\_\_\_\_ ft.

Sand \_\_\_\_\_

Gas \_\_\_\_\_

Oil \_\_\_\_\_

Total Depth \_\_\_\_\_

PRODUCTION

1st 24 hrs. Nat. \_\_\_\_\_

1st 24 hrs. after shot \_\_\_\_\_

Gas \_\_\_\_\_ Cu. Ft.

Dry Hole \_\_\_\_\_

Abandoned \_\_\_\_\_

Date

APR 2 1947 19 \_\_\_\_\_

S. J. LEWIS

Scout

Misc. Small Maps 7  
Cards RLB  
Tracing LM  
France Map /  
Scarborough Map /  
Pierce Map /  
Geological Dept. \_\_\_\_\_  
Pierce Plat Book \_\_\_\_\_



Misc. Small Maps *E*

Cards *WJ*

Tracing *WJ*

France Map *WJ*

Scarborough Map *WJ*

Pierce Map *WJ*


Geological Dept. *WJ*

Pierce Plot Book



check sheet  
no. 100-1111

100-1111

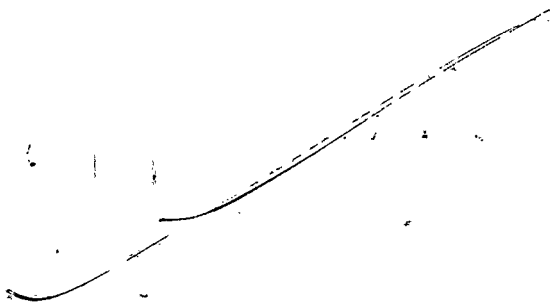

Misc. Small Maps	<input checked="" type="checkbox"/>
Cards	<input checked="" type="checkbox"/>
Tracing	<input checked="" type="checkbox"/>
France Map	<input checked="" type="checkbox"/>
Scarborough Map	<input checked="" type="checkbox"/>
Pierce Map	<input checked="" type="checkbox"/>
Geological Dept.	<input type="checkbox"/>
Pierce Map Book	<input type="checkbox"/>



Scout Cards	<i>MT</i>
Land Small Map	
Land Wall Map	<i>33</i>
Tracings	
France Map	
Pierce Map	
Misc.	

SEP 26 1952

Drig. Data



Scout Cards

Land Small Map

Land Wall Map

Tracings

France Map

Pierre Map

Misc.

JAN 23 1953

Orig. Data