

Section 20 Township 28 Range 9W

Well No. #2 Darlington

Company ~~Plains Exploration~~ NEBRASKA-WYOMING

NORTH

WEST

EAST

	0						

SOUTH

Sec. 20 Twp. - 28 R. 9W

Well No. #2 Darlington Farm

~~Nebreska - Wyoming~~
~~Plains Exploration~~

Company

Sterling- Contr.
Pat Creek

Contractor

Ft. from N. Line


NORTH

330' Ft. from S. Line

Ft. from E. Line

990' Ft. from W. Line

SE SW SW

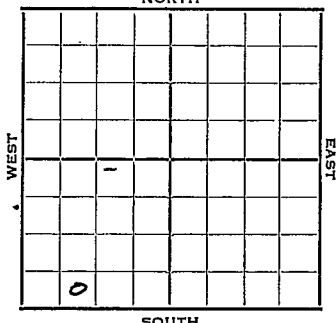

1952 Elev. 1722' REPORT

2/6 Location

2/13 Drlg. 1943'
8" @ 277'

2/20 Lans. 3506' Drlg. 3550'

3/5 B. Miss 4172 V 4397
DST 4394-4414 1 hr. 675' wtr 577' HOCM
#1320 BHP Arb. 4539
RTD 4561 5" @ 4540 WOCT

3/12 DP to TD 22 gal UPH MSO
Set plug 4535 12/4398 $\frac{1}{2}$ -4401 $\frac{1}{2}$
B/5 BOPH & Scum oil

3/19 Sq. to reperf

3/25 CO to 4535' 24/4511-17
B/21 gal oil & 5 gal wtr. 2 hrs.
B/48 gal oil 17 hrs. No wtr.
May Hyd.

4/1 Hyd. SO & W

4/9 Tub. & Rods

4/23 32/4474-92 S/34 gal oil 1 hr.
Hyd S/6 to 7 BOPH 20% wtr POP

4/30 NR

5/7 "

5/14 "

5/21 "

5/28 "

6/11 "

6/18 "

OVER

1952

6/25 NR

7/2 Spud 2-6-52
Oil well TD 4535' 8-5/8" @ 277
Br. line 3561' Lans. 3565'
DST 3925-50 open $\frac{1}{2}$ hr. rec 15' SGCM
Miss chat 4127' Kh. 4193'
B. Miss 4172' Viola 4397'
*DST 4384-4414 open 1 hr, red. 675' wtr.
575' HOCM. Arb. 4539'
TD 4561' 5" @ 4540' DP to 4561'
22 GWPH \ SP 4535' 12/3498-4401
B/5 BWPH & scum oil CO to 4535'
24/4511-17 B/21 GO 5 GW 2 hr.
B/48 GO 17 hr. 32/4474-92
S/34 GO Hydro. S/6 to 7 BOPH
Comp. 64 BOPD

COMPLETED

J. G. McGEHEE

Scout Cards _____

Land Small Map _____

Land Wall Map _____ 45

Tracings _____

France Map _____

Pierce Map _____

Misc. _____

8

1952

KANSAS

Map No. _____ Sec. 20 Twp. 28 R. 9W

Well No. 2 Darlington

Nebraska - Wyoming

Company _____

CORRECTION

Contractor _____

SE SW SW

SECTION PLAT

6			

_____ Ft. from N. Line

330 Ft. from S. Line

_____ Ft. from E. Line

990 Ft. from W. Line

Kingman County

Location _____

Rig up _____

Drilling and Remarks:

Reported

Plains Exploration

RECORD

Cased _____ in., _____ ft.

Sand _____

Gas _____

Oil _____

Total Depth _____

PRODUCTION

1st 24 hrs. Nat. _____

1st 24 hrs. after shot _____

Gas _____ Cu. Ft.

Dry Hole _____

Abandoned _____

Date

MAR 12 1952 19

J. G. McGEHEE Scout

10








Scout Cards

mm

MAR 14 1952

Land Small Map

Land Wall Map


Tracings

France Map

Pierce Map

Misc.

County Kingman State Kansas
 Sec. 20 (Blk.) 28 (Sur.) 9W Map No.
 Operator Plains Exploration Neb. - Wyo. Oil
 Well No. 2 Farm Darlington
 Elev. 1722 Location SE SW SW

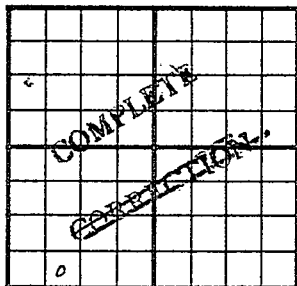

330 Ft. From S Line SW
990 Ft. From W Line Quarter

1st. Report

Completion JUL 9 1952

Remarks Pat Creek Pool

Sterling Drlg. - Contr.

Spudding Date 2-6-52

Drlg. Data Oil well TD 4535

8 5/8" @ 277 Br. lime 3561 Lans. 3565

DST 3925-50 open 1/2 hr. Rec. 15' sgcm

Miss. chat 4127 Kh. 4193 B. Miss. 4172

Viola 4397 DST 4384-4414 open 1 hr.

Rec. 675' water 575' hocm Arb. 4539

TD 4561 5" @ 4540 DP to 4561 22 gwph

SP 4535 12/ 3498-4401 B/ 5 bwph &

scum oil CO to 4535 24/ 4511-17

B/ 21 go 5 gw 2 hr. B/ 48 go 17 hr.

32/ 4474-92 S/ 34 go Hydro. S/ 6 to 7

boph Comp. 64 bopd

Scout Cards	<i>mm</i>
Land Small Map	
Land Wall Map	<i>G</i>
Tracings	
Finance Map	

JUL 9 1952

Orig. Data