


Section 20 Township 28 Range 9W

Well No. 3 Darlington

Company Nebraske & Wyoming Oil

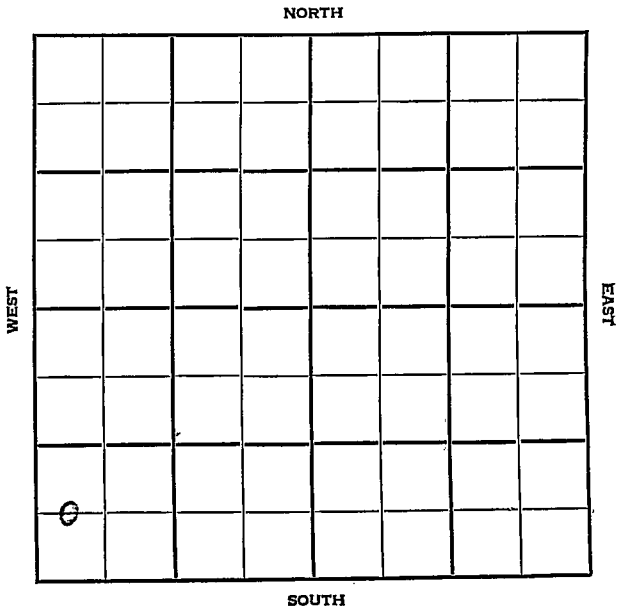

Kingman

SEC.	TWP.	R.
20	28	9W

WELL NO.

#3 Darlington

FARM

COMPANY

Nebraska & Wyoming Oil

CONTRACTOR

Sterling

Pat Creek


_____ Ft. from N. Line

_____ Ft. from S. Line

_____ Ft. from E. Line

_____ Ft. from W. Line

C W $\frac{1}{2}$ SW SW

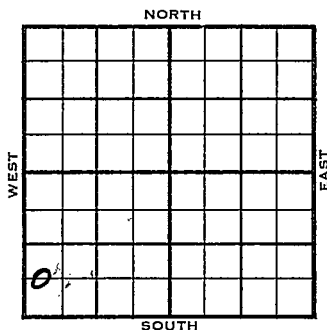

1955

ELEVATION

1702

REPORT

7/6

Comm 7-1-55
8" @282, Drlg. 1320

9/7

Comm 7-1-55
B1 3540
KC 3568
M 4116
K 4182
V 4390
S sh 4448
S sd 4470
A 4546
TD 4552

8" @ 282 DST 4388-90 open 1 hr.
~~Rec~~ Rec 10' ~~drilg~~ drlg mud DST 4383-95
open 1 hr Rec 184' O & gcm 2040'
O & gcsw 1150' sw 1470/20"
5 1/2" @ 4552 CO to 4520 20/4472-74
S/10 bopdr 30% wtr 5 hr
Comp 25' bopd 30% wtr.

COMPLETED

County Kingman Elev. _____
 Sec. 20 Twp. 28 Rge. 9W
 Company Nebraska & Wyoming Oil
 Farm Name Darlington No. 3

TOPS	DEPTH	LOG	DATUM
Anh.			
Tp.			
H.			
Tr.			
Dg.			
Bl.			
L.			
K.C.			
B.K.C.			
Ce.			
C.			
M.			
M.			
K.			
Mz.			
Mo.			
V.			
S.			
S.			
A			
R.			
Pe.			
G.			
T.D.			

Loc. in Sec. C W¹/₂ SW SW

Geol. _____

Contr. Sterling

Pool Pat Creek

FINAL REPORT
 JUL 6 1955

Date Comm. 7-1-55
8" @ 282 drlg. 1320

27

Co.
Lse.
No.
Sec.
T.
R.

County Kingman Elev. 1702
 Sec. 20 Twp. 28 Rge. 9W
 Company Nebraska & Wyoming Oil
 Farm Name Darlington No. 3

TOPS	DEPTH	LOG	DATUM	Loc. in Sec.
Anh.				C W $\frac{1}{2}$ SW SW
Tr.				
Dg.				
Bl.	3540		1838	
L.				Geol.
K.C.	3568		1866	Contr.
B.K.C.				
Ce.				
C.				Sterling
M.	4116		2414	Pool
M.				Pat Creek
K.	4182		2480	
Mz.				
Ma.				
V.	4390		2688	COMPLETE
S.	4448		2746	
S.	4470		2768	
A	4548		2844	
R.				
PE.				
G.				
T.D.	4552			

Date Comm. 7-1-55 SEP 7 1955

8" @ 282 DST 1,388-90 open 1 hr.

Rec. 10' drlg. mud DST 1,383-91 open 1 hr.

Rec. 18 1/4' o & gcm 2040' o & gcm

1150' sw 1470/20" 5 1/2" @ 1552 CO to 1520

20/ 1472-74 S/ 10 boph 30% wtr. 5 hr.

Comp. 25 bopd 30% wtr.