


Section 20 Township 28 Range 9-17

Well No. #2 Swander

Company Plains Exploration
Pat Creek Pool

NORTH

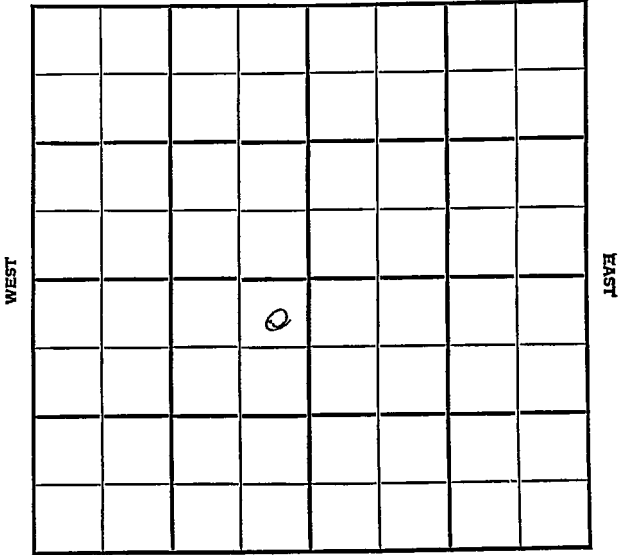

SOUTH

Sec. 20 Twp. 28 R. 9W

Well No. #2 Swander Farm _____

Plains Exploration Company

Pat Creek Pool


330' Ft. from N. Line

_____ Ft. from S. Line

330' Ft. from E. Line

_____ Ft. from W. Line

NE SW

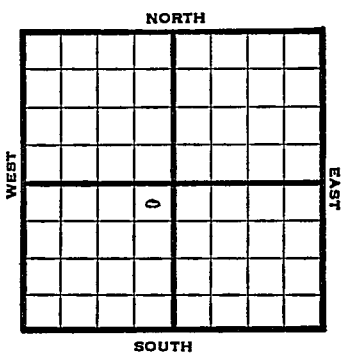

1948 E1 1718' REPORT

5/26

RUR

6/1

8^m @ 280'
Drlg. 1740'

Sp 4475
1718
 2757

6/9

Drlg. 3760'

6/16

Lansing 3548'
Mississippi 4123'
Drlg. 4305'

6/23

TD 4616'
Viola 4407'
Simp. 4475'
Arb. 4579'
Aband.

ABANDONED

Map No. _____ Sec. 20 Twp. 28 R. 9W

Well No. 2 Swander

Plains Exploration Company

FIRST REPORT

Contractor _____

NE SW


SECTION PLAT

330 Ft. from N. Line

_____ Ft. from S. Line

330 Ft. from E. Line

_____ Ft. from W. Line

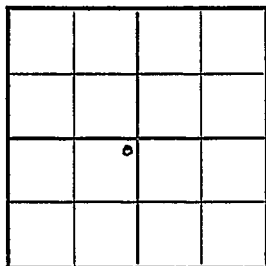

Kingman County

Location _____

Rig up _____

Drilling and Remarks:

R U R

RECORD

Cased _____ in., _____ ft.

Sand _____

Gas _____

Oil _____

Total Depth _____

PRODUCTION

1st 24 hrs. Nat. _____

1st 24 hrs. after shot _____

Gas _____ Cu. Ft.

Dry Hole _____

Abandoned _____

Date

MAY 26 1948 19 _____ S. J. LEWIS Scout

Map No. 316 Sec. 20 Twp. 28 R. 9W

Well No. 2 Swander

Plains Exploration Company

ABANDONED Contractor

NE SW

E11718
SECTION PLAT

330 Ft. from N. Line

 Ft. from S. Line

330 Ft. from E. Line

 Ft. from W. Line

	Δ		

Kingman County

Location

Rig up

Drilling and Remarks:

Vista 4407
Sing 4425
Co 44579

RECORD

Cased in., ft.

Sand

Gas

Oil

Total Depth 4616

PRODUCTION

1st 24 hrs. Nat.

1st 24 hrs. after shot

Gas Cu. Ft.

Dry Hole

Abandoned

Date

JUN 23 1948 19 S. J. LEWIS Scout