


WELL COMPLETION REPORT AND DRILLER'S LOG

API No. 15 — 057 — 20,189
County Number

KANSAS
State Geological Survey
WICHITA BRANCH

S. 10 T. 28S R. 21 E. W
Loc. 1320' FNL & 330' FEL
County Ford County

Operator Texas Oil & Gas Corp.			
Address 200 W. Douglas, Suite 300, Wichita, KS 67202			
Well No. #2X	Lease Name Kirkpatrick		
Footage Location 1320' foot from (N) XX line 330' foot from (E) YY line			
Principal Contractor Slawson, Rig #6		Geologist Bill Clark	
Date 11-1-80	Date Completed 11-27-80	Total Depth 5150'	P.B.T.D. 5128'
Directional Deviation Not directionally drilled		Oil and/or Gas Purchaser Delhi Gas Pipeline	

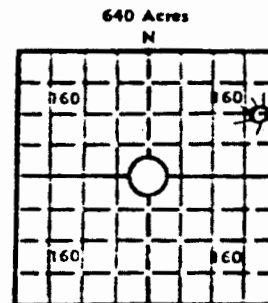

Locate well correctly
Elev.: Gr. 2349
DF KB 2355

CASING RECORD

Report of all strings set — surface, intermediate, production, etc.

Purpose of string	Size hole drilled	Size casing set (in O.D.)	Weight lbs/ft.	Setting depth	Type cement	Sacks	Type and percent additives
Surface	12 1/4"	8-5/8"	24#	599'		450	
Production		2-7/8"	6.5#	5142'		175	

LINER RECORD

PERFORATION RECORD

Top, ft.	Bottom, ft.	Sacks cement	Shots per ft.	Size & type	Depth interval
N/A	N/A	N/A	3 JSPF (12 h.)	Miss.	5010-14'

Size	Setting depth	Packer set at
N/A	N/A	N/A

ACID, FRACTURE, SHOT, CEMENT SQUEEZE RECORD

Amount and kind of material used	Depth interval treated
Dumped 4 bbls acetic acid & 4 bbls 2% KCl wtr	
Acidized w/250 gals 15% HCl w/surfactant & cla-sta	5010-14'

INITIAL PRODUCTION

Date of first production 1-24-81	Producing method (flowing, pumping, gas lift, etc.) flowing
RATE OF PRODUCTION PER 24 HOURS N/A	Oil Gas Water Gas-oil ratio N/A
Position of gas (vented, used on lease or sold) Sold: Delhi Gas Pipeline	Producing interval(s) 5010-14'

INSTRUCTIONS: As provided in KCC Rule 82-2-125, within 90 days after completion of a well, one completed copy of this Drillers Log shall be transmitted to the State Geological Survey of Kansas, 4150 Monroe Street, Wichita, Kansas 67209. Copies of this form are available from the Conservation Division, State Corporation Commission, 245 No. Water, Wichita, Kansas 67202. Phone AC 316-522-2206. If confidential custody is desired, please note Rule 82-2-125. Drillers Logs will be on an open file in the Oil and Gas Division, State Geological Survey of Kansas, Lawrence, Kansas 66044.

FIELD: Pleasant Valley (Miss.)

Operator
Texas Oil & Gas Corp.

DESIGNATE TYPE OF COMP.: OIL, GAS,
DRY. HOLE, SWDW. ETC.:

Gas

Well No.
2X

Lease Name
Kirkpatrick

S 10 T 28S R 21 W

WELL LOG

Show all important zones of porosity and contents thereof; cored intervals, and all drill-stem tests, including depth interval tested, cushion used, time tool open, flowing and shut-in pressures, and recoveries.

SHOW GEOLOGICAL MARKERS, LOGS RUN,
OR OTHER DESCRIPTIVE INFORMATION.

FORMATION DESCRIPTION, CONTENTS, ETC.	TOP	BOTTOM	NAME	DEPTH
LOG TOPS				
Herington	2581	-226		
Winfield	2645	-290		
Towanda	2707	-352		
Ft. Riley	2763	-408		
Wreford	2916	-561		
Cottonwood	3103	-748		
Foraker	3265	-910		
Onaga	3373	-1018		
Wabaunsee	3387	-1032		
Stotler	3510	-1155		
Tarkio	3561	-1206		
Burl.	3653	-1298		
Howard	3709	-1354		
Heebner	4163	-1808		
Toronto	4183	-1828		
Douglas Grp.	4200	-1845		
Iatan	4312	-1957		
Lansing	4319	-1964		
Stark	4615	-2260		
Swope	4623	-2268		
Hertha	4673	-2318		
B/KC	4743	-2388		
Marmaton	4758	-2403		
Pawnee	4827	-2472		
Cherokee	4879	-2524		
Miss.	4979	-2624		
TD	5150			
PBD	5128			
Ran O.H. Logs				
No DSTs.				

USE ADDITIONAL SHEETS, IF NECESSARY, TO COMPLETE WELL RECORD.

Date Received

Harold R. Trapp
District Geologist

Signature

Title

January 29, 1981

Date

DRILLERS LOG

10-28-21W
State Geology Survey
WICHITA BRANCH

OPERATOR: Texas Oil & Gas Corp.
200 West Douglas
Wichita, Kansas 67202

WELL NAME: Kirkpatrick 'X' #2
300' NW of N/2 SE NE Sec. 10-28S-21W
Ford County, Kansas

CONTRACTOR: Slawson Drilling Company, Inc.
200 Douglas Building
Wichita, Kansas 67202

COMMENCED: 11/1/80

COMPLETED: 11/9/80

SURFACE CASING: 8-5/8" set at 599' with 450 sx

PRODUCTION CASING: 2-7/8" set at 5142' with 175 sx

CONDUCTOR PIPE: 16" set at 107' by Jr. Rat Hole Service

RTD: 5150'

107' to 509' Sand
509' to 603' Shale & Lime
603' to 1870' Sand & Shale
1870' to 3355' Shale & Lime
3355' to 3566' Lime & Shale
3566' to 4060' Shale & Lime
4060' to 4660' Lime & Shale
4660' to 4773' Lime
4773' to 4845' Lime & Shale
4845' to 4907' Shale & Lime
4907' to 5101' Lime
5101' to 5150' Lime & Shale
RTD 5150'

85/8 249'/27534
KB 2353

#2 Kirkpatrick
C N/2 SE NE
10-28-21W
D & A 10/31/80
RTD 543
Shid Rig to #2 "X" Kirkpatrick
E/2 E/2 NE
SE

STATE OF KANSAS

COUNTY OF SEDGWICK

I, James C. Remsberg, of the Slawson Oil Company, Inc. hereby state the above is an accurate copy of the Kirkpatrick 'X' #2 log for Texas Oil & Gas Corp.

James C. Remsberg
James C. Remsberg