


Section 21 Township 28 Range 5 WWell No. #2 ReinholdCompany E. F. Wakefield

NORTH

WEST

EAST

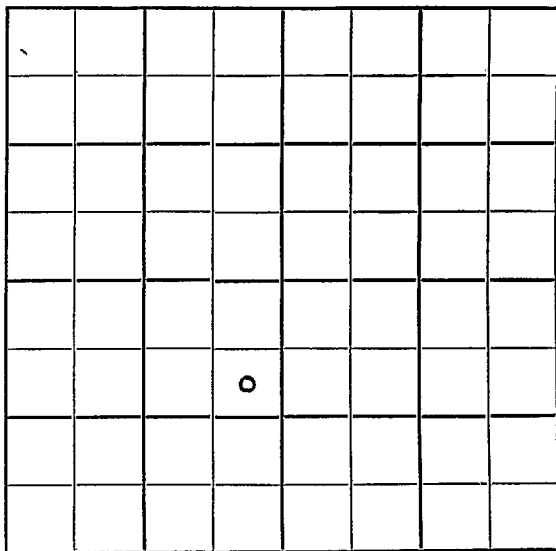

SOUTH

Sec. 21 Twp. 28 R. 5W ✓

Well No. #2 Reinhold Farm
E. F. Wakefield Company

Contractor

Broadway Pool


990' Ft. from N. Line

_____ Ft. from S. Line

330' Ft. from E. Line

_____ Ft. from W. Line

SE NE SW

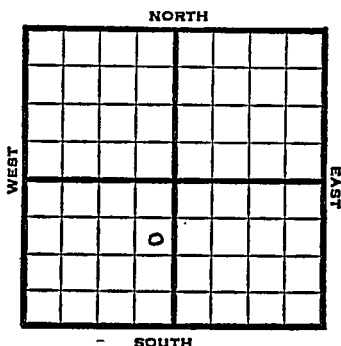

1951

Elev. 1348 REPORT

1/24

Location

5/9

Spud 3-14-51

Oil Well TD 3835

8" @ 130

Miss Chat 3794 Dol. 3829

TD 3835 5" @ 3830

S/16 bopd S/21 bo 8 bwpd

2000 A Comp. 105 bopd

10% wtr.

COMPLETED

County Kingman State Kansas

Sec. **21** (Blk.) **28** (Sur.) **5W** Map No.

Operator **E. F. Wakefield**

Well No. **2** Farm **Reinhold**

Elev.	Location	SE NE SW
-------	----------	-----------------

FIRST REPORT

990 Ft. From N Line SW

330 Ft. From: E Line Quarter

1st. Report JAN 24 1951

Completion

Remarks:

Spudding Date _____

Drig. Data Broadway Pool

Location

JAN 29 1951

Scout Cards
Land Small Map
Land Wail Map
Tracings
France Map
Pierce Map
Misc.

Brig. Data

J. E. TYRA

MAY 15 1951

Scout Cards	
Land Small Map	
Land Wall Map	
Tracings	
France Map	
Pierce Map	
Misc.	

Drig. Data