

Sec. 21 Twp. 28 R. 5W

Well No. #3 Broadway Farm

Atlantic Company

Wakefield - Contr. Contractor


Broadway Pool

Ft. from N. Line

990' Ft. from S. Line

Ft. from E. Line

330' Ft. from W. Line

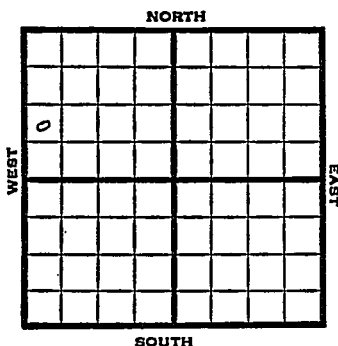

NW SW NW

1951

Elev. 1396' REPORT

5/9

RUR

6/27

Spud 5-12-51

Oil well TD 3903' 8" @ 160

Br. line 3006' Lans. 3025'

KC 3210' Miss 3806' Do1 3841'

TD 3897' 5" @ 3899'

SIM 3897 equals 3903' TD PB 3861'

48/3835-51 500 A F/5 BOPH 50% water

SP 3842' PB 3842' 500 A

F/3 BOPH 54% water F/2 BOPH

54% water

Comp. F/84 BOPD 30% water

COMPLETED

County Kingman State Kansas

Sec. 21 (Blk. Twp.) 28 (Sur. Rge.) 5W Map No.

Operator Atlantic

Well No. 3 Farm Broadway

Elev. Location NW SW NW

0							

990 Ft. From S Line NW

330 Ft. From W Line Quarter

lst. Report MAY 9 1951

Completion _____

Remarks _____

Wakefield - Contr.

Spudding Date _____

Drlg. Data Broadway Pool

R U R

County Kingman State Kansas

Sec. 21 (Blk. Twp.) 28 (Sur. Rge.) 5W Map No.

Operator Atlantic

Well No. 3 Farm Broadway

Elev. 1396 Location NW SW NW

990 Ft. From S Line NW

330 Ft. From W Line Quarter

1st. Report

Completion JUN 27 1951

Remarks Broadway Pool

Wakefield - Contr.

Spudding Date 5-12-51

Drlg. Data Oil well TD 3903

8" @ 160 Br. line 3006 Lans. 3025

KC 3210 Miss. 3806 DoI. 3841 TD 3897

5" @ 3899 SIM- 3897=3903 TD PB 3861

48/ 3835-51 500' A F/ 5 bfph 50% water

SP 3842 PB 3842 500 A F/ 3 boph

54% water F/ 2 boph 54% water

Comp. F/ 84 bopd 30% water