


Section 21 Township 28 Range 5 W

Well No. # 4 Broadway

Company Atlantic

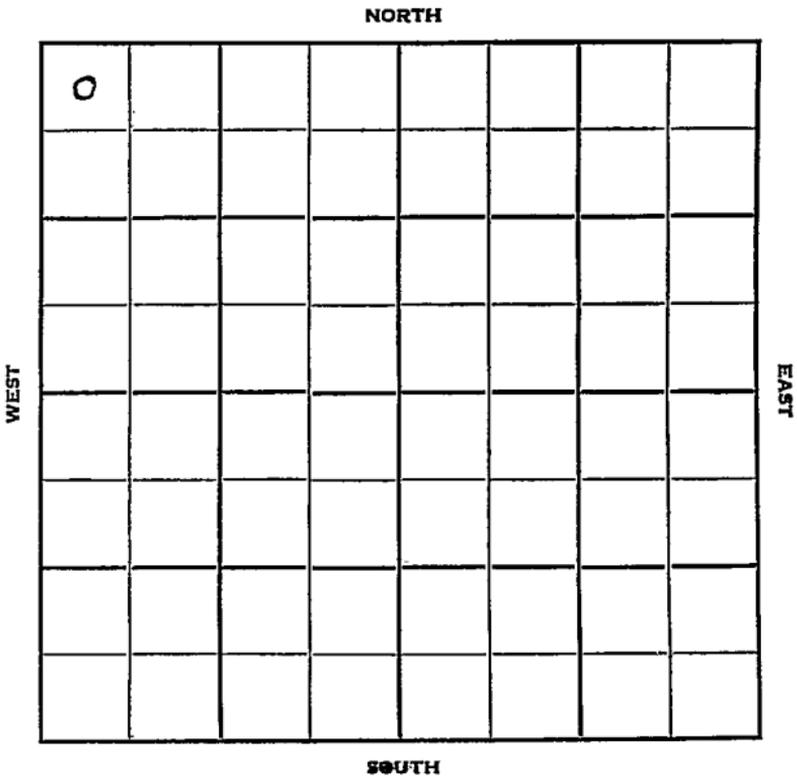

Sec. 21 Twp. 28 R. 5 W ✓

Well No. # 4 Broadway Farm

Atlantic Company

Wakefield Contractor

Broadway Pool


330 Ft. from N. Line

\_\_\_\_\_ Ft. from S. Line

\_\_\_\_\_ Ft. from E. Line

330 Ft. from W. Line

NW NW NW

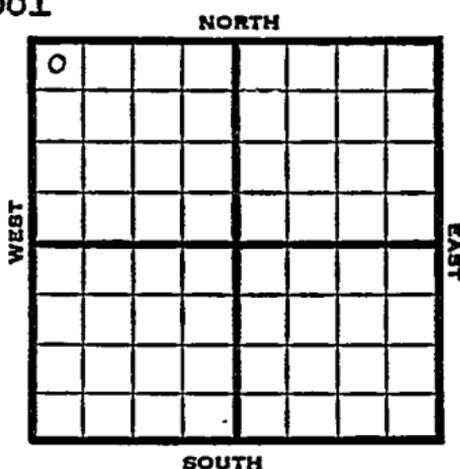

1951

Elev. 1391' REPORT

5/29

R U R

8/15

Oil Well TD 3895  
 9" @ 167  
 Br Line 2997  
 Lans. 3014  
 Miss 3800  
 DST 3816-50 opn 1 hr  
 Rec. 412' oil & mud  
 7" @ 3892 TD 3895  
 12/3832-34 3 gw 1 go 108/3814-32  
 3 go 28 gw 500 A P/157 bf 34% wtr  
 P 20 bf 4 hr. 12% wtr.  
 Comp. 106 bopd 12% wtr.

**COMPLETED**

County Kingman State Kansas

Sec. 21 (Blk. Twp.) 28 (Sur. Rge.) 5W Map No.

Operator Atlantic

Well No. 4 Farm Broadway

Elev. Location NW NW NW

0					

330 Ft. From N Line NW

330 Ft. From W Line Quarter

Ist. Report MAY 29 1951

Completion \_\_\_\_\_

Remarks \_\_\_\_\_

Wakefield - Contr.

Spudding Date \_\_\_\_\_

Drlg. Data Broadway Pool

R U R

Scout Cards *mm*  
Land Small Map  
Land Wall Map *39*  
Tracings  
France Map  
Pierce Map  
Misc.

JUN 1 195

Orig. Date

County Kingman State Kansas

Sec. 21 (Blk. 28) (Twp. 5W) (Sur. Map No.) (Rge.)

Operator Atlantic

Well No. 4 Farm Broadway

Elev. 1391 Location NW NW NW

0							
<b>COMPLETE</b>							

330 Ft. From N Line NW

330 Ft. From W Line Quarter

Ist. Report

AUG 15 1951

Completion

Remarks Broadway Pool

Wakefield - Contr.

Spudding Date

Drlg. Data Oil well TD 3895

9" @ 167 Br. lime 2997 Lans. 3014

Miss. 3800 DST 3816-50 open 1 hr.

Rec. 412' oil & mud 7" @ 3892 TD 3895

12/ 3832-34 3 gw 1 go 108/ 3814-32

3 go 28 gw 500-A P/ 157 bf 34% water

P/ 20 bf 4 hr. 12% water

Comp. 106 bopd 12% water

Scout Cards \_\_\_\_\_  
Land Small Map \_\_\_\_\_  
Land Wall Map 33 \_\_\_\_\_  
Tracings .....  
France Map .....  
Pierce Map .....  
Misc. ....

1951