


Section 21 Township 28 Range 5 W

Well No. #1 Broadway

Company Atlantic

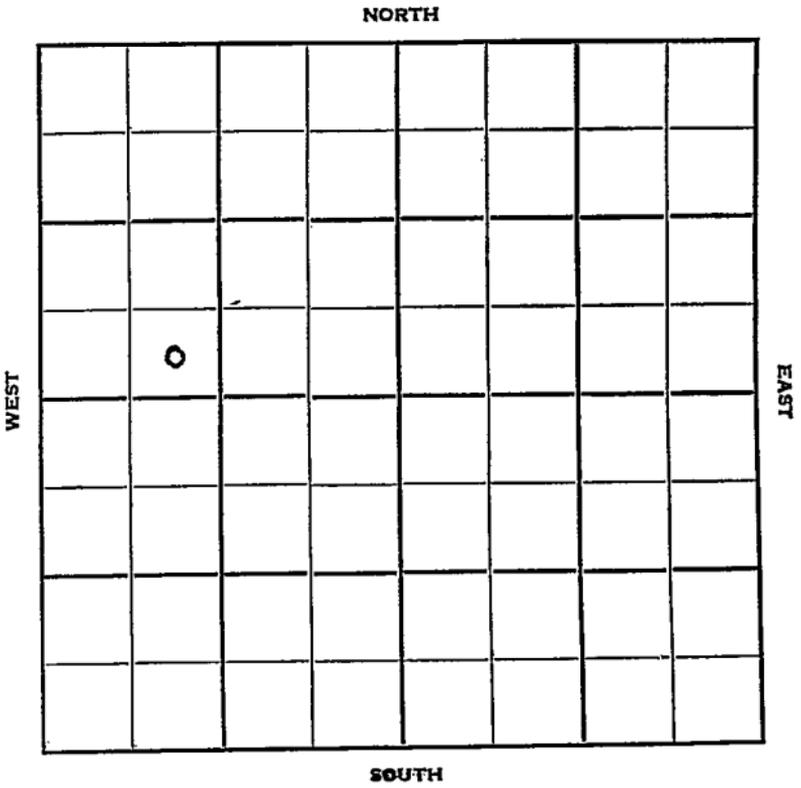

Sec. 21 Twp. 28 R. 5W

Well No. #1 Broadway Farm

Atlantic Company

Wakerfield - Contr. Contractor


Ft. from N. Line

330' Ft. from S. Line

Ft. from E. Line

990' Ft. from W. Line

SE SW NW

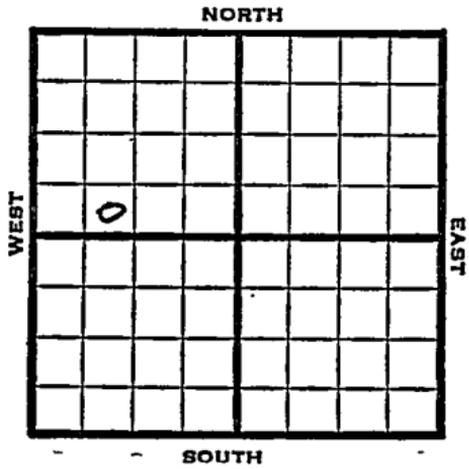

1951

Elev. 1390' REPORT

1/24

8" @ 165'

3/28

Oil Well TD 3890

8" @ 165'

Heeb. 2679' Toronto 2719

Br Line 2998' Lans. 3016'

Miss 3806'

DST 3808-25 opn 1 hr Rec. 110' gcm

SSO TD 3890

64/3821-45 F/20 bo & died

500 A F/20 boph for 2 hrs

F/9 boph Comp. 3838 bopd

15% wtr

COMPLETED


County Kingman State Kansas

Sec. 21 (Blk. 28) (Sur. 5W) (Twp. 28) (Rge. 5W) Map No.

Operator Atlantic

Well No. 1 Farm Broadway

Elev. _____ Location SE SW NW

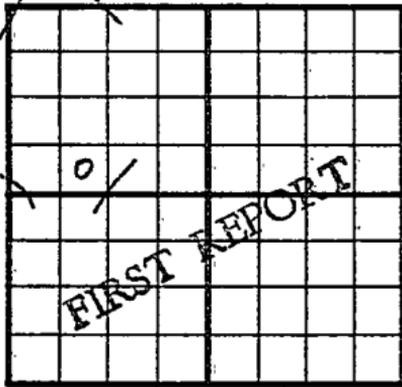

330 Ft. From S Line NW

990 Ft. From W Line Quarter

Ist. Report JAN 24 1951

Completion _____

Remarks _____

Wakefield - Contr.

Spudding Date _____

Drilg. Data _____

8" @ 165

J. E. TYRA

County Kingman State Kansas

Sec. 21 (Blk. 28) (Sur. 5W) (Twp.) (Rge.) Map No.

Operator Atlantic

Well No. 1 Farm Broadway

Elev. 1390 Location SE SW NW

330 Ft. From S Line NW

990 Ft. From W Line Quarter

1st. Report

Completion MAR 28 1951

Remarks

Wakefield - Contr.

Spudding Date

Drilg. Data Oil well TD 3890

8" @ 165 Heeb. 2679 Toronto 2719

Br. lime 2998 Lans. 3016 Miss. 3806

DST 3808-25 open 1 hr. Rec. 110' gcm

SSO TD 3890 64/ 3821-45 F/ 20 bo &

died 500 A F/ 20 boph for 2 hr.

F/ 9 boph Comp. 383 bopd 14% water

J. E. TYRA