


Section 21 Township 28 Range 5W

Well No. #1 Broadway

Company L. F. Wakefield

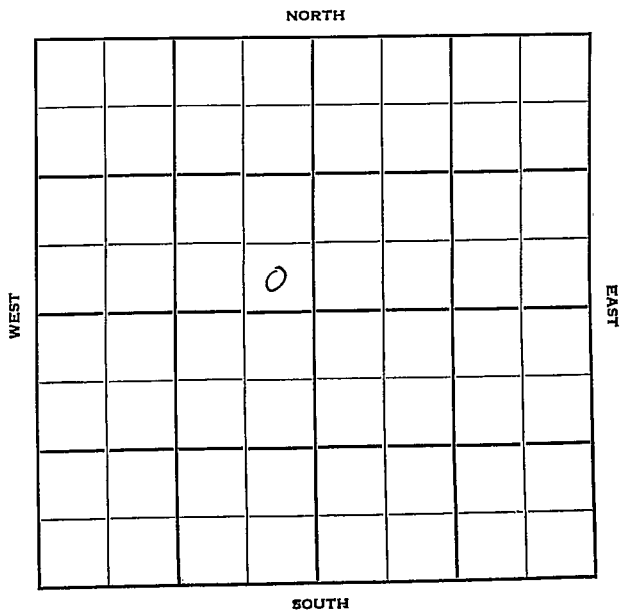

21

28

5W ✓

Sec. \_\_\_\_\_ Twp. \_\_\_\_\_ R. \_\_\_\_\_

Well No. #1 Broadway Farm

L. F. Wakefield Company

Wakefield - Contr. Contractor

Wildcat

Ft. from N. Line

330'


Ft. from S. Line

330'

Ft. from E. Line

Ft. from W. Line

SE SE NW

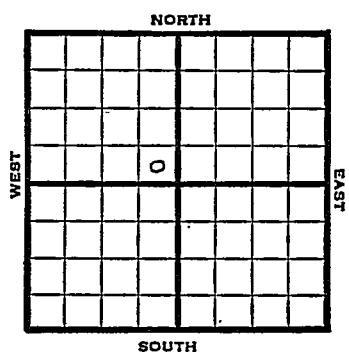

1950

Elev. 1384' REPORT

6/21

Spud 6-19-50  
8" @ 143'  
Drilg.

10/4

Spud 6-19-50  
 Oil Well TD 4361'  
 8" @ 143'  
 Br Lime 2991' Lans. 3008'  
 Miss 2797'  
 DST 3798-3822 Rec. 200,000 gas  
 175' GCM DST 3822-36 opn 45 min  
 Rec. 80' free oil 160' OCM 30' SW  
 Dol 3815' Kinderhook 4072'  
 Viola 4194' Simp. 4212'  
 Krb 4331-61  
 5" @ 3894'  
 8/3833-36 S& F/61 BW 8 BO  
 S/& F 24 BO 17 BW S & F/ 42 BO 13 BW  
 F/40 BO 22 hr. F/95 BO 48 hr.  
 F/42 BOPD Comp. F/20 BOPD  
 Grav. 35  
**COMPLETED**

Kansas

Map No. \_\_\_\_\_ Sec. 21 Twp. 28 R. 5W

Well No. 1 Broadway

L. F. Wakefield Company

Contractor

SE SE NW

\_\_\_\_\_ Ft. from N. Line

330 Ft. from S. Line


330 Ft. from E. Line

\_\_\_\_\_ Ft. from W. Line

Kingman County

Atl. &amp; CSO DFM

## SECTION PLAT

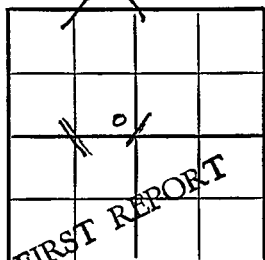

Location \_\_\_\_\_

Rig up \_\_\_\_\_

Drilling and Remarks: \_\_\_\_\_

Spud 6-19-50

8" @ 143

drlg.

## RECORD

Cased \_\_\_\_\_ in., \_\_\_\_\_ ft.

Sand \_\_\_\_\_

Gas \_\_\_\_\_

Oil \_\_\_\_\_

Total Depth \_\_\_\_\_

## PRODUCTION

1st 24 hrs. Nat. \_\_\_\_\_

1st 24 hrs. after shot \_\_\_\_\_


Gas \_\_\_\_\_ Cu. Ft.

Dry Hole \_\_\_\_\_

Abandoned \_\_\_\_\_

Date

JUN 21 1950 19 J. E. TYRA Scout

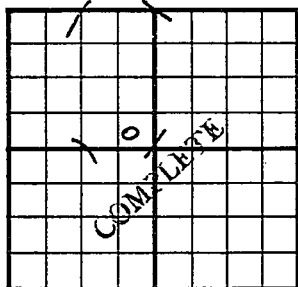County Kingman State KansasSec. 21 (Blk. Twp.) 28 (Sur. Rge.) 5W Map No.Operator E. H. WakefieldWell No. 1 Farm BroadwayElev. 1384 Location SE SE NW330 Ft. From S Line NW330 Ft. From E Line Quarter

1st. Report

Completion OCT 4 1950Remarks WildcatWakefield - Contr.Spudding Date 6-19-50Drlg. Data Oil well TD 43618" @ 143 Br. lim<sup>8</sup> 2991 Lans. 3008Miss. 2797 DST 3798-3822 Rec. 200,000 gas175' gcm DST 3822-35 open 45 min.Rec. 80' free oil 160' ocm 30' swDol. 3815 Kinderhook 4072 Viola. 4194Simp. 4212 Arb. 4331-61 5" @ 38948/ 3833-36 S & F/ 61 bw 8 boS/ & F/ 24 bo 17 bw S & F/ 42 bo 13 bwF/ 40 bo 22 hr. F/ 95 bo 48 hr.F/ 42 bopd Comp. F/ 20 bopd gr. 35

J. E. TYRA