

Section 22 Township 28 Range 5W

Well No. #1 Lindholm (B)

Company Beardmore

NORTH

WEST

EAST

☉							

SOUTH

Kingman

~~KANSAS~~

Sec. 22 Twp. 28 R. 1 5W

Well No. #1 Lindholm (B) Farm

Beardmore Company

Ardemore - Contr. Contractor


330' Ft. from N. Line

Ft. from S. Line

Ft. from E. Line

330' Ft. from W. Line

NW NW NW

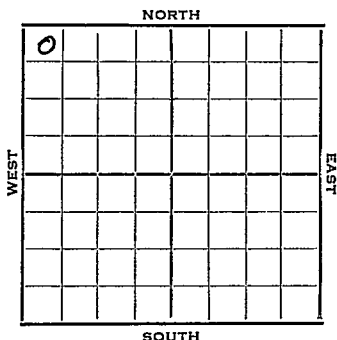

1952 Elev. 1392' REPORT

4/9 Location

4/23 8" @ 125 Drlg 1035'

4/30 Lans. 3008' Miss 3798'

DST 3826-34, 1 hr, 60' SOCM 390#

DST 3826-36 1 hr, 10 mins. 50' GCM

110' SOCM, 40' wtr. 680#

5" @ 3826'

5/7 DP CO 3836 Fill up 200' oil & 200 wtr 14 hrs. To A

5/13 Spud 4-19-52 D&A TD 3860'

8" @ 125 Lans. 3008 Miss. 3798

DST 3826-34 open 1 hr. rec. 60' socm

DST 3826-36 open 1 hr. rec. 50' gcm

110' socm 40' wtr. 5" @ 3826'

CO to 3836 FU 200' oil 200' wtr.

14 hr. 2500 A FU 200' oil 300' wtr.

14 hr. DD 3860' D&A

ABANDONED

County Kingman State KansasSec. 22 (Blk.) 28 (Sur.) 5W Map No.Operator BeardmoreWell No. 1 Farm Lindholm (B)Elev. _____ Location NW NW NW

0							

330 Ft. From N Line NW330 Ft. From W Line QuarterIst. Report APR 9 1952

Completion _____

Remarks _____

Beardmore - Contr.

Spudding Date _____

Drlg. Data _____

Location _____

J. G. McGEHEE

County Kingman State Kansas
 Sec. 22 (Blk. 28) (Sur. 5W) Map No. 1
 Operator Beardmore Drlg.
 Well No. 1 Farm Lindholm "B"
 Elev. 1392 Location NW NW NW

0							

ABANDONED

330 Ft. From N Line NW

330 Ft. From W Line Quarter

1st. Report

Completion MAY 14 1952

Remarks

Beardmore - Contr.Spudding Date 4-19-52Drlg. Data TD & A TD 38608" @ 125 Lans. 3008 Miss. 3798DST 3826-34 open 1 hr. Rec. 60' socmDST 3826-36 open 1 hr. Rec. 50' gcm110' socm 40' water 5" @ 3826CO to 3836 FU 200' oil 200' water 14 hr2500 A FU 200' oil 300' water 14 hr.DD 3860 D & A

J. G. McGEE