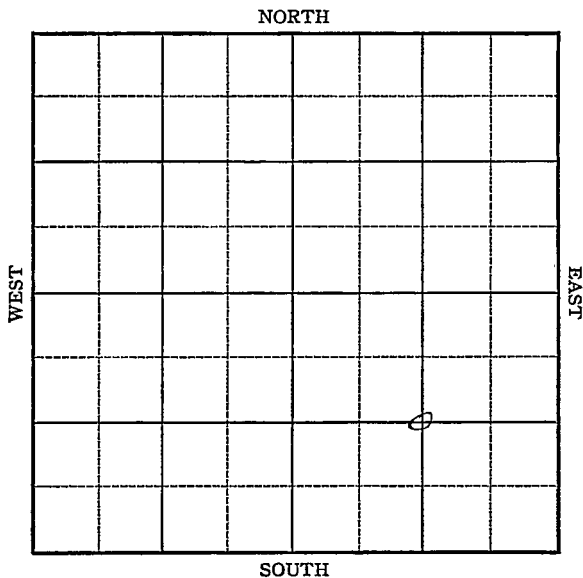


Section 22 Township 28 Range 37-WWell No. #1-22 HelmleyCompany R. K. Wilson

Grant

KANSAS

Map No. N M Sec. 22 Twp. 28 R. 37WWell No. 1-22 - HelmleyR K Wilson

Company

Contractor

FIRST REPORT
C SE

SECTION PLAT

 Ft. from N. Line1320 Ft. from S. Line1320 Ft. from E. Line Ft. from W. LineLocation XRig up

Drilling and Remarks:

RECORD

Cased in. ft.Sand Gas Oil Total Depth

PRODUCTION

1st 24 hrs. Nat. 1st 24 hrs. after shot Gas Cu. Ft.Dry Hole Abandoned

Date

SEP 29 1927 19 H. D. Hatfield Scout

Grant

KANSAS

Map No. _____ Sec. 22 Twp. 28 R. 37WWell No. 1 - 22 - HelmleyR. K. Wilson


Company

COMPLETED

Contractor

C SE

SECTION PLAT

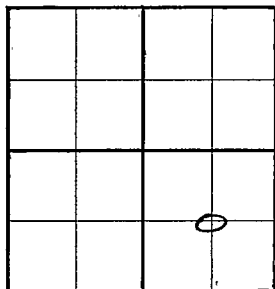

_____ Ft. from N. Line

1320 Ft. from S. Line1320 Ft. from E. Line

_____ Ft. from W. Line

Location _____

Rig up _____

Drilling and Remarks:

shot 200 gts7 1/2 M gas

RECORD

Cased 7 in., 2233 ft.Sand 7

Gas _____

Oil _____

Total Depth 2720

PRODUCTION

1st 24 hrs. Nat. _____

1st 24 hrs. after shot _____

Gas _____ Cu. Ft.

Dry Hole _____

Abandoned _____

Date

NOV 10 1937

19

H. D. Hatfield Scout