


Section 22 Township 28 Range 33W

Well No. 1 Barber

Company Cities Service Oil etal

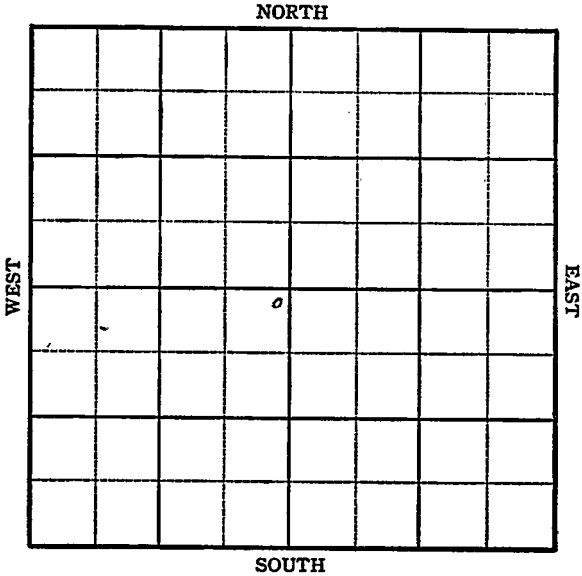

Sec. 22 Twp. 28 R. 33-W

Well No. #1 Barber Farm


Cities Service Oil etal Company

100 Ft. from N. Line

\_\_\_\_\_ Ft. from S. Line

100 Ft. from E. Line

\_\_\_\_\_ Ft. from W. Line

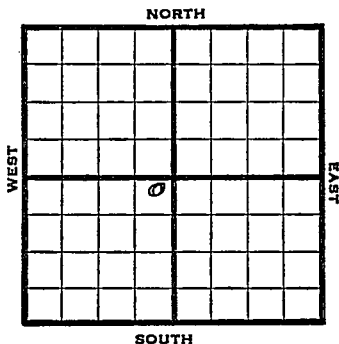

NE SW

1945 Elev. 2971 REPORT

10/17 Location  
 10/24 8" @ 756 .  
 Drlg. 2382  
 10/31 5" @ 2808  
 TD 2810 RUST  
 11/7 122 shots 2685-2758  
 15500 acid  
 11/14 " " " "  
 11/21 5" @ 2808  
 Perf. 15,500 acid.  
 TD 2810  
 6,406,000 Gas.  
 390# R Pr.

COMPLETED

KANSAS Kansas Pool Name Hugoton

Map No. no map Sec. 22 Twp. 28 R. 33W

Well No. 1 Barber

Cities Service Oil etal Company

**FIRST REPORT** Contractor

NE SW

**SECTION PLAT**

100 Ft. from N. Line

\_\_\_\_\_ Ft. from S. Line

100 Ft. from E. Line

\_\_\_\_\_ Ft. from W. Line


Haskell County

Location X

Rig up \_\_\_\_\_

Drilling and Remarks: \_\_\_\_\_

**RECORD**

Cased \_\_\_\_\_ in., \_\_\_\_\_ ft.

Sand \_\_\_\_\_

Gas \_\_\_\_\_

Oil \_\_\_\_\_

Total Depth \_\_\_\_\_

**PRODUCTION**

1st 24 hrs. Nat. \_\_\_\_\_

1st 24 hrs. after shot \_\_\_\_\_

Gas \_\_\_\_\_ Cu. Ft.

Dry Hole \_\_\_\_\_

Abandoned \_\_\_\_\_

Date

OCT 17 1945 19

S. J. LEWIS Scout

