


Section 22 Township 28 Range 34-W
Well No. #1 Cook
Company Northern Natural Gas

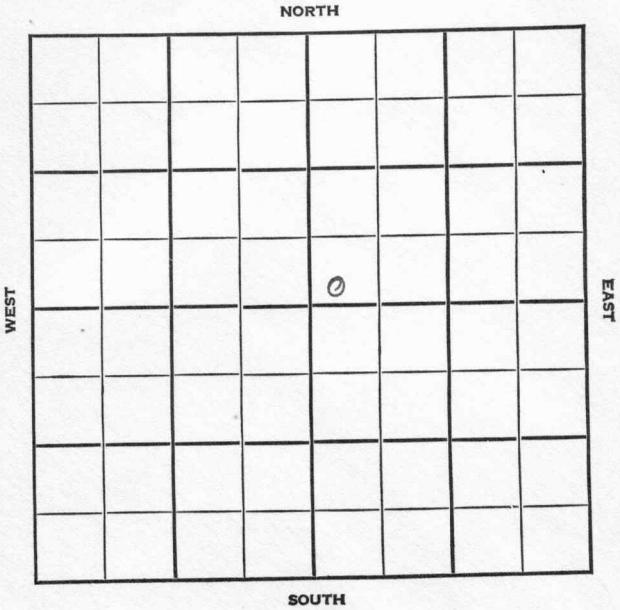

KANSAS

Haskell

Sec. 22 Twp. 28 R. 34W

Well No. #1 Cook Farm

Northern Natural Gas Company

Hugoton Pool


 Ft. from N. Line

200' Ft. from S. Line

 Ft. from E. Line

200' Ft. from W. Line

SW NE

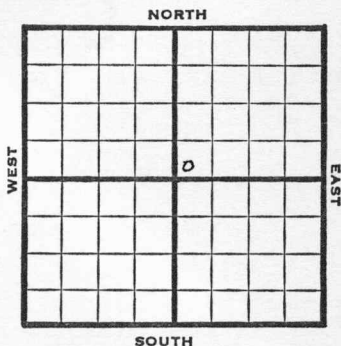

1948

Eli 3023'

REPORT

6/16

Location

6/24

10" @ 525'
Drlg. 1839'

6/29

TD 2545
7"@ 2518'
RUST

7/8

225' of 5" Perf Liner @ 2764'
TD 2764'
14000 acid

7/14

"

7/21

"

7/28

"

8/4

7"@ 2518'
225' of 5" Perf liner @ 2764'
TD 2764'
14000 acid
10,860,000 gas
414 # R pr.
Comp

COMPLETED

Map No. _____ Sec. 22 Twp. 28 R. 34W

Well No. 1 Cook

Northern Natural Gas Company

FIRST REPORT Contractor

SW NE

SECTION PLAT

		o	

_____ Ft. from N. Line

200 Ft. from S. Line

_____ Ft. from E. Line

200 Ft. from W. Line

Haskell County

Location X

Rig up _____

Drilling and Remarks:

RECORD

Cased _____ in., _____ ft.

Sand _____

Gas _____

Oil _____

Total Depth _____

PRODUCTION

1st 24 hrs. Nat. _____

1st 24 hrs. after shot _____

Gas _____ Cu. Ft.

Dry Hole _____

Abandoned _____

Date

JUN 16 1948 19 S. J. LEWIS Scout

Haskell County Kansas StateMap No. _____ Sec. 22 Twp. 28 R. 34WWell No. 1 CookNorthern Natural Gas CompanyCOMPLETE Contractor


SW NE

E/3023
SECTION PLAT

_____ Ft. from N. Line

200 Ft. from S. Line

_____ Ft. from E. Line

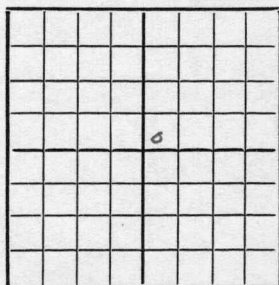220 Ft. from W. LineHugoton Pool

Remarks:

7" @ 2518225' of 3" Perf liner @ 2764WT 276414000000010,560,000 Gas414 # R₂Date
AUG 4 1948Scout
S. J. LEWIS