

22

28

21W


SECTION \_\_\_\_\_ TOWNSHIP \_\_\_\_\_ RANGE \_\_\_\_\_

#1 Karns

WELL NO. \_\_\_\_\_

Rupp-Ferguson, Sunray & Skelly

COMPANY \_\_\_\_\_

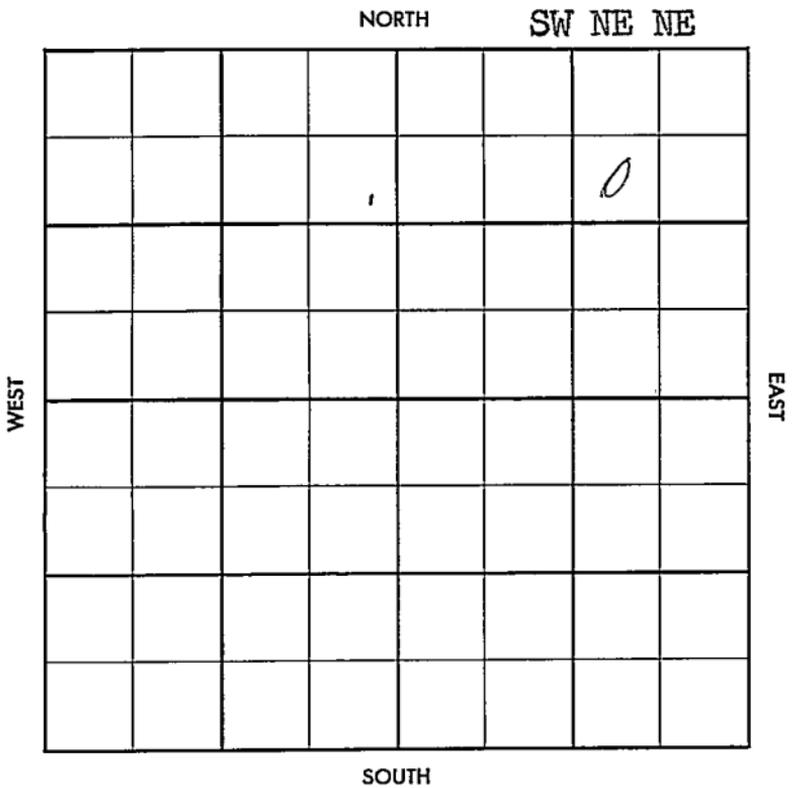

# HOT FILE Ford KANSAS

SEC. A TWP. R.

22

28 S

21 W

WELL NO.

#1 Karns

FARM

COMPANY

Rupp-Ferguson (DEVELOPMENT-OBOC)

CONTRACTOR Skelly & SDX

Co. tools.

Pleasant Valley Fld.

1250 FT. FROM N. LINE

NORTH

FT. FROM S. LINE

1250 FT. FROM E. LINE

WEST

FT. FROM W. LINE

EAST

of Sec.

SW NE NE (OPERATING AGREEMENT 378<sup>50</sup>/57)

1957	ELEVATION 2373'	REPORT	(WH7-EX3) ✓
------	--------------------	--------	-------------

5100' Miss Test

4/3 Spudded 3-30-57  
Drlg. 1990'  
8" @ 375/225 (FR Tkt) (DR#66-1957)

4/4 TD 1990' NR

4/5 Drlg. 2850'

4/8 Drlg. 3090'

4/9 Drlg. 4125'

4/10 Drlg. 4397'

4/11 Drlg. 4571'

4-12 Drlg. 4741'

4-15 Drlg. 4861'

4-16 Drlg. 5132' - Running E.L.

4-17 TD 5132'. NR

4/18 TD 5132' P & A (DR#77-1957)

4/17 Comm. 3-30-57  
8" @ 375/225  
Hb 4205' BL 4355' Lsg 4363'  
Miss. 5031'  
DST 5027-42, op 30", rec 12' mud.  
No press.  
DST 5042-80', op 1 hr rec 14' Drlg.  
mud. FP 90-60# BHP O# 20".  
TD 5132' D & A (Sct. Comp. Tkt)

**ABANDONED** ✓

County Fond Elev. \_\_\_\_\_  
 Sec. 22 Twp. 28 Rge. 21W  
 Company Rupp-Ferguson, Sunray & Skelly  
 Farm Name Karns No. 1

TOPS	DEPTH	LOG	DATUM
Anh.			
Tp.			
H.			
Tr.			
Dg.			
Bl.			
L.			
K.C.			
B.K.C.			
Ce.			
C.			
M.			
M.			
K.			
Mz.			
Mo.			
V.			
S.			
S.			
A.			
R.			
Pe.			
G.			
T.D.			

Loc. in Sec. SW NE NE  
1250' fnl x  
1250' fel  
 Geol. \_\_\_\_\_  
 Contr. \_\_\_\_\_  
 Co. Tools \_\_\_\_\_  
 Pool \_\_\_\_\_


FIRST REPORT  
 APR 3 '57

Date Comm. 3-30-57  
8" @ 375/225, Drlg. 1990

24

Co.

Lse.

No.

Sec.

T.

R.

