


FORD

KANSAS

DX 78-1

Section 22 Township 28 Range 25W
Well No. #1 Burnett
Company Kewanee Oil

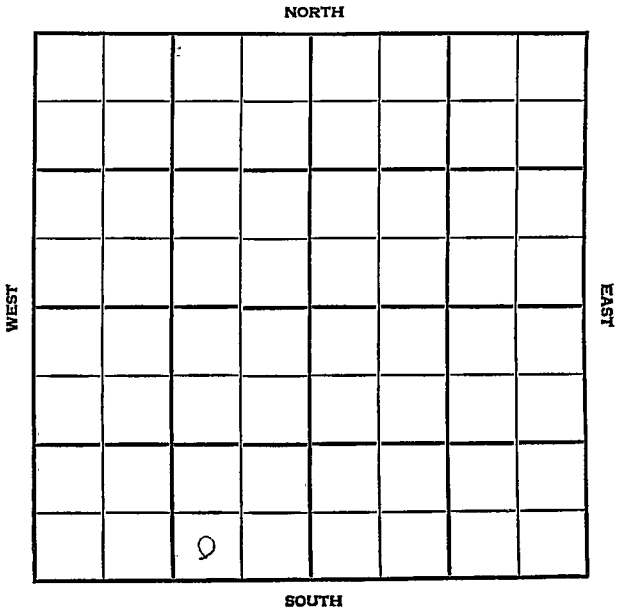

Ford

KANSAS


SEC. 22	TWP. 28	R. 25W
------------	------------	-----------

WELL NO. #1 Burnett FARM

COMPANY
Kewanee Oil

CONTRACTOR
#

_____ FT. FROM N. LINE
 _____ FT. FROM S. LINE
 _____ FT. FROM E. LINE
 _____ FT. FROM W. LINE

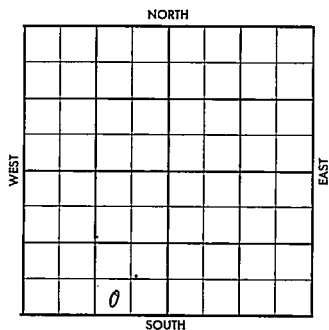

SW SE SW

1956	ELEVATION 2621 DF	REPORT
------	----------------------	--------

6-13 Location
 Comm. 6-9-56

8-15 8 5/8" @ 344 w/300
 D & A
 H. 4282'; L. 4389'; BK C 4822';
 M. 5188'; V. 6051'; S. 6188';
 A. 6229';
 TD 6278'

6000' test

ABANDONED

County Ford Elev. _____
 Sec. 22 Twp. 28 Rgs. 2 SW
 Company Keenee Oil
 Farm Name Burnett No. 1

TOPS	DEPTH	LOG	DATUM
Anh.			
Tp.			
H.			
Tr.			
Dg.			
Bl.			
L.			
K.C.			
B.K.C.			
Ce.			
C.			
M.			
M.			
K.			
Mz.			
Me.			
V.			
S.			
S.			
A.			
R.			
PE.			
G.			
TD.			

Loc. in Sec. _____
SW SE SW
6000' test
 Geol. _____
 Contr. _____
 Pool _____

FIRST REPORT
 JUN 13 '56

Date Comm. 6-9-56
 Location _____

~~24~~

JUN 13 1956

Co.
Lse.
No.
Sec.
T.
R.

County Ford Elev. 2621 DF
 Sec. 22 Twp. 28 Rge. 2 SW
 Company Kewanee Oil
 Farm Name Burnett No. 1

TOPS	DEPTH	LOG	DATUM	Loc. in Sec.
Anh.				SW SE SW
Tr.				6000' test
H.	4282			
Tr.				
Dg.				
Bl.				
L.	4389			Geol.
K.C.				Contr.
B.K.C.	4822			
Ce.				
C.				
M.	5188			Pool
M.				
K.				
Mz.				
Mo.				
V.	6051			ABANDONED
S.	6188			
S.				
A.	6229			
R.				
PE.				
G.				
TD.	6278			

Date Comm. 6-9-56 AUG 15 '56

Location JUN 20 '56 ✓ JUN 27 '56 ✓ JUL 3 '56 X
 JUL 11 '56 X 7-5-56 8 7/8 @ 344/300
 Ⓟ 2537 JUL 18 '56 Ⓟ 4133 JUL 25 '56
 Ⓟ 5180 AUG 7 '56 Ⓟ 5677 AUG 8 '56
 Ⓟ 6208 AUG 15 '56

DEO