FORM 51 5M BRIX


KANSAS

22 Pratt

Section 22 Township 28 Range 12W

Well No. #3 Dowell

Company Skelly

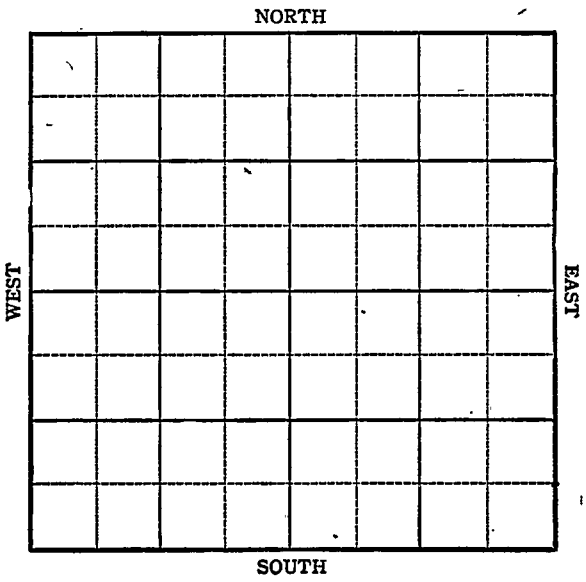

FORM 252-A
5M 3-44 PETRO

KANSAS

Pratt

Sec. 22 Twp. 28 R. 12W

Well No. #3 Dowdal Farm

Skelly Company


Chitwood

Ft. from N. Line

990 Ft. from S. Line

Ft. from E. Line

990 Ft. from W. Line

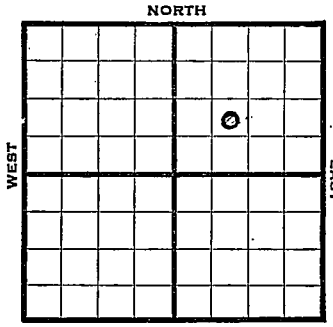

Elev. 1868

1944	REPORT
8/2	Location
8/9	Rotary
8/16	8" @ 384 Drlg. 800
8/23	Drlg. 3175
8/30	Drlg. 4360
9/8	Lans 3709 Miss 4144 Kind 4194 Viola 4278 Simp sd 4395 TD 4398 SO 5" @ 4396 RUST
9/13	" " " "
9/21	TD 4410 Flow 30' oil 1 hr.
9/28	Flow 691 oil in 15 hrs.
10/4	Simp sd 4395 5" @ 4395 Bomb pot. 1656 TD 4410 Grav. 41.4

COMPLETED

FORM 56 200 BKS. 1-44 PETROL

Pool Name Chitwood

KANSAS

Map No. SE Sec. 22 Twp. 28 R. 12W


Well No. 3 Dowell

Skelly Company

FIRST REPORT Contractor

NE SW NE

SECTION PLAT

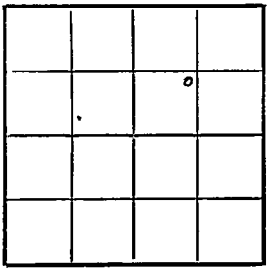

____ Ft. from N. Line

990 Ft. from S. Line

____ Ft. from E. Line

990 Ft. from W. Line

Pratt County

Location X

Rig up

Drilling and Remarks:

RECORD

Cased ____ in., ____ ft.

Sand

Gas

Oil

Total Depth

PRODUCTION

1st 24 hrs. Nat.

1st 24 hrs. after shot

Gas ____ Cu. Ft.

Dry Hole

Abandoned

Date

AUG 2 1944 19 S. J. LEWIS Scout

FORM 26 200 BKS. 2-44 PETROL

Pool Name Chitwood Pool

Map No. 54 Sec. 22 Twp. 28 R. 12W


Well No. 3 Dowell

Skelly Company

COMPLETED Contractor

NE SW NE

SECTION PLAT

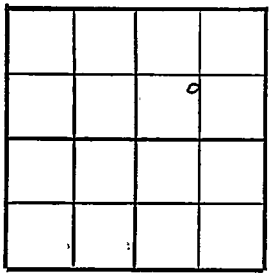

Ft. from N. Line

990 Ft. from S. Line

Ft. from E. Line

990 Ft. from W. Line

Pratt County

Location

Rig up

Drilling and Remarks:

Surf Sd 4395'

SO 4896

Bonn & Pf. 1656

4 1/2 Gu

RECORD

Cased in., ft.

Sand

Gas

Oil

Total Depth 4410

PRODUCTION

1st 24 hrs. Nat.

1st 24 hrs. after shot

Gas Cu. Ft.

Dry Hole

Abandoned

Date

OCT 4 1944 19

S. J. LEWIS Scout