





KANSAS

Sec. 22 Twp. 28 R. 12W

Well No. #8 Dowell Farm  
Skelly Company

Chitwood


990 Ft. from N. Line

Ft. from S. Line

330 Ft. from E. Line

Ft. from W. Line

SE NE NE

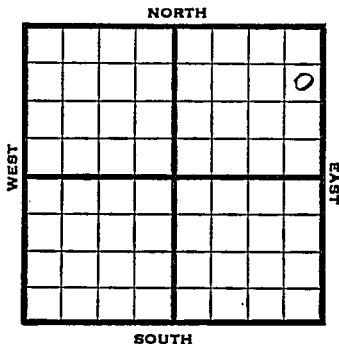

1946

Elev. 1881

REPORT

- 4/10 RUR
- 4/16 8" @ 368 Drlg 2840
- 4/23 Drlg 4145'
- 5/1 Lans 3715  
Miss 4152  
Viola 4282  
Simp sd 4406-08  
TD 5" @ 4406  
RUST
- 5/7 TD 4417-00  
20 qts 4406-14 CO
- 5/14 " " "
- 5/22 Simp sd. 4402  
5" @ 4402  
20 qts. 4406-4414  
TD 4417'  
Bomb Pot. 799  
Grav. 40.1

COMPLETED

**KANSAS**

Kansas Pool Name Chitwood

Map No. 57 Sec. 22 Twp. 28 R. 12W

Well No. 8 Dowell

Skelly Company

**FIRST REPORT** Contractor

SE NE NE

**SECTION PLAT**

990 Ft. from N. Line

\_\_\_\_\_ Ft. from S. Line

330 Ft. from E. Line

\_\_\_\_\_ Ft. from W. Line

			o

Pratt County

Location \_\_\_\_\_

Rig up \_\_\_\_\_

Drilling and Remarks:

R U R

**RECORD**

Cased \_\_\_\_\_ in., \_\_\_\_\_ ft.

Sand \_\_\_\_\_

Gas \_\_\_\_\_

Oil \_\_\_\_\_

Total Depth \_\_\_\_\_

**PRODUCTION**

1st 24 hrs. Nat. \_\_\_\_\_

1st 24 hrs. after shot \_\_\_\_\_

Gas \_\_\_\_\_ Cu. Ft.

Dry Hole \_\_\_\_\_

Abandoned \_\_\_\_\_

Date

APR 10 1946 19

S. J. LEWIS Scout

