


Section 22 - Township 28 Range 12W

Well No. 5 Dowell

Company Skelly

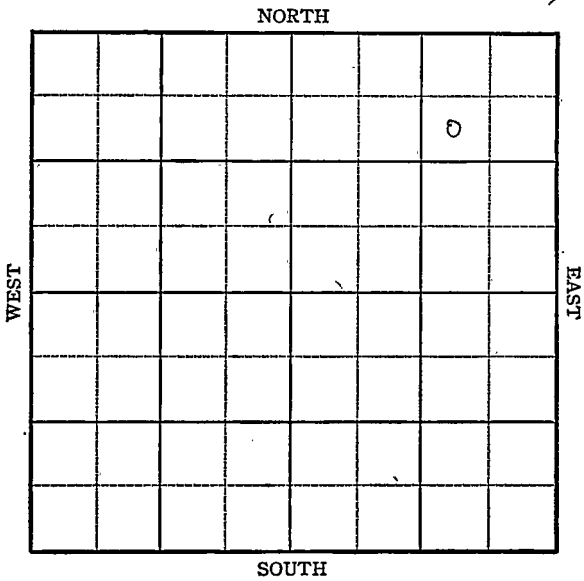

KANSAS Pratt

Sec. 22 Twp. 28 R. 12-W

Well No. #5 Dowell Farm


Skelly Company

990 Ft. from N. Line

\_\_\_\_\_ Ft. from S. Line

990 Ft. from E. Line

\_\_\_\_\_ Ft. from W. Line

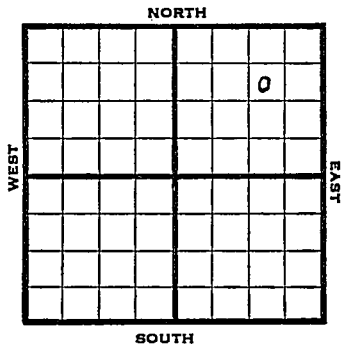

SW NE NE

1945 Elev. 1870 REPORT

- 9/26 Location
- 10/3 Derrick
- 10/10 RUR
- 10/17 8" @ 384  
Drlg. 1565
- 10/24 Drlg. 3100'
- 10/31 Drlg. 4180'
- 11/7 Lans 3 3704  
Viola 4276  
Simp Sd4396  
TD 4398  
5" @ 4396 RUST
- 11/14 TD 4417  
1000 acid.  
Flow 122 oil in 4 hrs.
- 11/21 " " " " "
- 11/28 Simp Sd. 4396  
5" @ 4396  
1000 acid.  
TD 4417  
Bomb Pot. 1178  
Grav. 40.9

COMPLETED

**KANSAS**

Kansas Pool Name Chitwood

Map No. 54 Sec. 22 Twp. 28 R. 12W

Well No. 5 Dowell

Skelly Company

**FIRST REPORT** Contractor

SW NE NE

**SECTION PLAT**

990 Ft. from N. Line

\_\_\_\_\_ Ft. from S. Line

990 Ft. from E. Line

\_\_\_\_\_ Ft. from W. Line

			o

Pratt County

Location X

Rig up \_\_\_\_\_

Drilling and Remarks: \_\_\_\_\_

**RECORD**

Cased \_\_\_\_\_ in., \_\_\_\_\_ ft.

Sand \_\_\_\_\_

Gas \_\_\_\_\_

Oil \_\_\_\_\_

Total Depth \_\_\_\_\_

**PRODUCTION**

1st 24 hrs. Nat. \_\_\_\_\_

1st 24 hrs. after shot \_\_\_\_\_

Gas \_\_\_\_\_ Cu. Ft.

Dry Hole \_\_\_\_\_

Abandoned \_\_\_\_\_

Date

SEP 26 1945 19 S. J. LEV Scout

