

KANSAS


FORM 51 5M PETROL

Pratt

Section 22 Township 28 Range 12W

Well No. #1 Fissel

Company Cities Service Oil

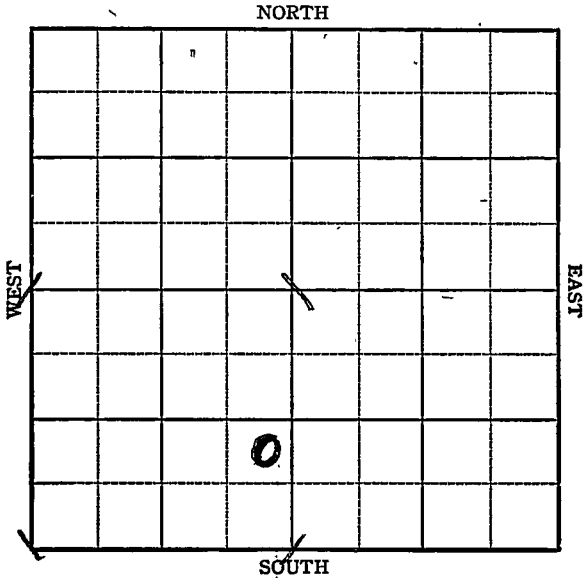

KANSAS


Pratt

Sec. 22 Twp. 28 R. 12-W

Well No. #1 Fissell Farm

Cities Service Oil Company

NORTH

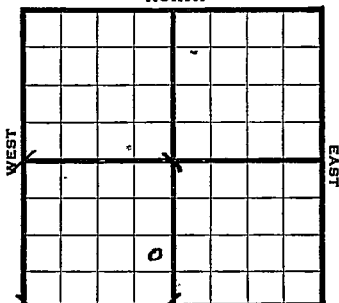

_____ Ft. from N. Line

990 Ft. from S. Line

330 Ft. from E. Line

_____ Ft. from W. Line

Whitwood *Elev. 1875*

1944 REPORT

3/15	Location.
3/22	"
3/29	"
4/5	10" @ 350 WOC?
4/12	D lg. 2785
4/19	Lans 3722 SSO Drlg. 4034
4/26	Cong 4170 Viola 4302 Drlg. 4400
5/3	Simp 4403-09 TD 5" @ 4404 RUST
5/10	" "
5/17	T.D. 4425 900' oil in 12 hrs.
5/24	500 acid flow 6½ oil Per hr. 15 hrs.
5/31	Bomb test 1018 1000 acid

OVER

1944

6/7 5" @ 4404
Simp. 4403
TD 4425
1500 acid
Bomb Pot. 1200
38.6 Gravity.

COMPLETED

Map No. KANSAS Sec. 22 Twp. 28 R. 12W

Well No. 1 Fissel

Cities Service Oil Company

FIRST REPORT

Contractor

NE SE SW


SECTION PLAT

 Ft. from N. Line

990 Ft. from S. Line

330 Ft. from E. Line

 Ft. from W. Line

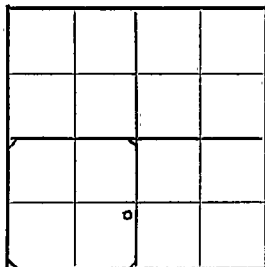

Chitwood Pool

Location X

Rig up

Drilling and Remarks:

RECORD

Cased in., ft.

Sand

Gas

Oil

Total Depth

PRODUCTION

1st 24 hrs. Nat.

1st 24 hrs. after shot

Gas Cu. Ft.


Dry Hole

Abandoned

Date

MAR 15 1944 19

S. J. LEWIS Scout

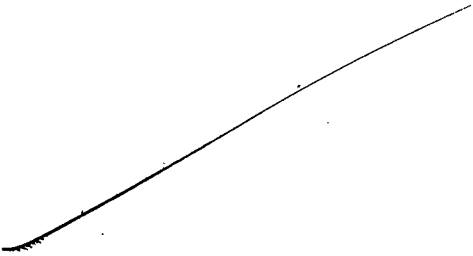

M sc. Small Maps	<i>Small</i>
Cards	<i>Small</i>
Tracing	<i>Small</i>
France Map	<i>Small</i>
Scarborough Map	<i>Small</i>
Moody Map	<i>Small</i>
Geological Dept.	
Moody Plat Book	

KANSAS

Pool Name ChitwoodMap No. 4 Sec. 22 Twp. 28 R. 12WWell No. 1 FisselCities Service Oil CompanyCOMPLETED Contractor

NE SE SW

SECTION PLAT

_____ Ft. from N. Line

990 Ft. from S. Line330 Ft. from E. Line

_____ Ft. from W. Line

Pratt County

Location _____

Rig up _____

Drilling and Remarks:

Surf 44035-10-44041500 cu ftBone & Pot 1200385 lbs

RECORD

Cased 1 1/2 in., _____ ft.

Sand _____

Gas _____

Oil _____

Total Depth 4425

PRODUCTION

1st 24 hrs: Nat. _____

1st 24 hrs. after shot _____

Gas _____ Cu. Ft.

Dry Hole _____

Abandoned _____

Date

JUN 7 1944 19

S. J. LEWIS Scout

Moody Plat Book