


Section 22 Township 28 Range 12W

Well No. 3 Hillard

Company F. C. Koch etal

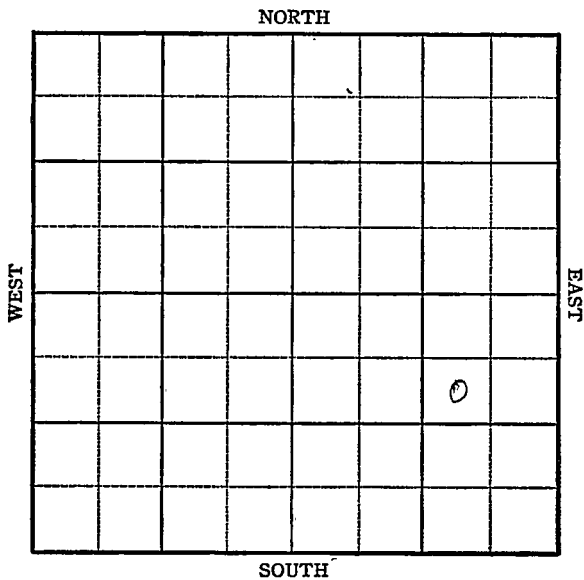

Sec. 22 Twp. 28 R. 12-W


Well No. #3 Hillard Farm  
F. C. Koch etal Company

990 Ft. from N. Line

\_\_\_\_\_ Ft. from S. Line

990 Ft. from E. Line

\_\_\_\_\_ Ft. from W. Line

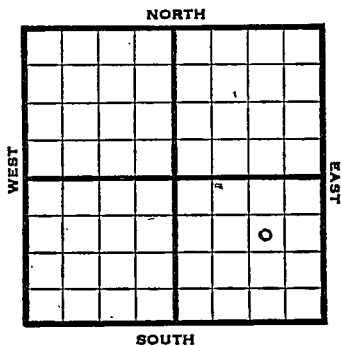

SW NE SE

REPORT	
1945	Elev. 1863
11/21	8" @ 353' TD 1300'
11/28	Drlg. 3700
12/5	Drlg. 4250
12/12	Lans 3699 Miss 4148 Viola 4286 Simp Sd. 4380 TD 4460 5" @ 4460 RUST
12/20	48 shots 4308-38' 1000 acid. 7 M Gas.
12/29	" "
1946	
1/9	Simp Sd. 4380 5" @ 4460 103 shots 4386-4415 2000 acid. TD 4460 Bomb Pot. 4392 Max. 3000 Grav. 40.9

COMPLETED



