
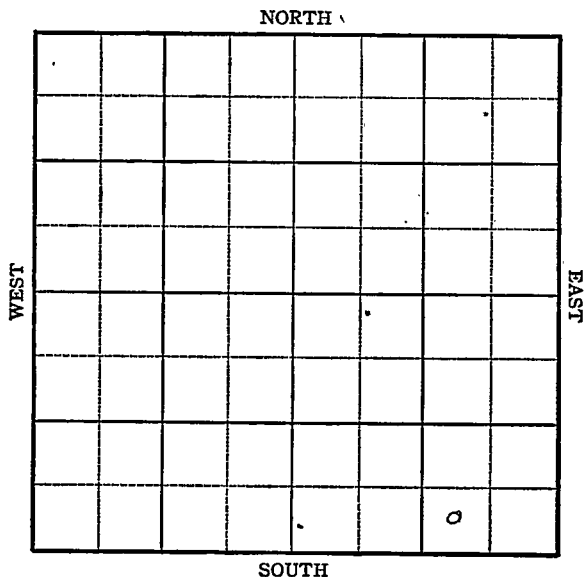


Section 22 Township 28 Range 12WWell No. 4 HillardCompany F. C. Koch etal

Sec. 22 Twp. 28 R. 12-W

Well No. #4 Hillard Farm
F. C. Koch et al Company

 Ft. from N. Line
330 Ft. from S. Line
990 Ft. from E. Line
 Ft. from W. Line

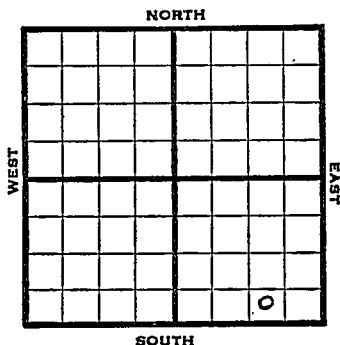

SW SE SE

1945	Elev. 1866	REPORT
11/28	Location	
12/5	"	
12/12	RUR	
12/20	8" - 355' Drlg. 2020'	
12/29	Fsg. 2700'	
1946		
1/10	Lans. 3706' Drlg. 4040'	
1/17	Miss 4167' Viola 4301'	
	Simp Sand 4396' Drlg. 4410'	
1/24	T.D. 4435' 5" - 4434'	
	RUST.	
1/31	"	
2/7	68 shots 4398-4420' 2000 acid.	
	Flow 45 oil per hour.	
2/14	Bomb test 2064	
2/21	" "	
2/27	Simp Sd. 4396	
	5" @ 4434	
	Perf. Simp. 2000 acid.	
	TD 4435'	
	Bomb Pot. 2064	
	Grav. 39.0	

COMPLETED

KANSAS, Pool Name ChitwoodMap No. 5-4 Sec. 22 Twp. 28 R. 12WWell No. 4 HillardF. C. Koch et al CompanyFIRST REPORT Contractor

SW SE SE

SECTION PLAT

			o

Ft. from N. Line330 Ft. from S. Line990 Ft. from E. LineFt. from W. LinePratt CountyLocation xRig upDrilling and Remarks:

RECORD

Cased _____ in., _____ ft.

Sand _____

Gas _____

Oil _____

Total Depth _____

PRODUCTION

1st 24 hrs. Nat. _____

1st 24 hrs. after shot _____

Gas _____ Cu. Ft.

Dry Hole _____

Abandoned _____

Date

NOV 28 1945 19 S. J. LEWIS Scout

Kansas Pool Name Chitwood
 Map No. 54 Sec. 22 Twp. 28 R. 12W
 Well No. 4 Hillard

F. C. Koch et al Company

COMPLETED

Contractor

SW SE SE

E. 1866
SECTION PLAT

			0

 Ft. from N. Line

330

 Ft. from S. Line

990

 Ft. from E. Line

 Ft. from W. Line

Pratt County

Location

Rig up

Drilling and Remarks:

Sample 4386
5/24/43

Perf Snip
2000 acid
Born X B X 2064

39 1/2 lb

RECORD

Cased in., ft.

Sand

Gas

Oil

Total Depth 4425

PRODUCTION

1st 24 hrs. Nat.

1st 24 hrs. after shot

Gas Cu. Ft.

Dry Hole

Abandoned

Date

FEB 27 1946

19

S. J. LEWIS

Scout