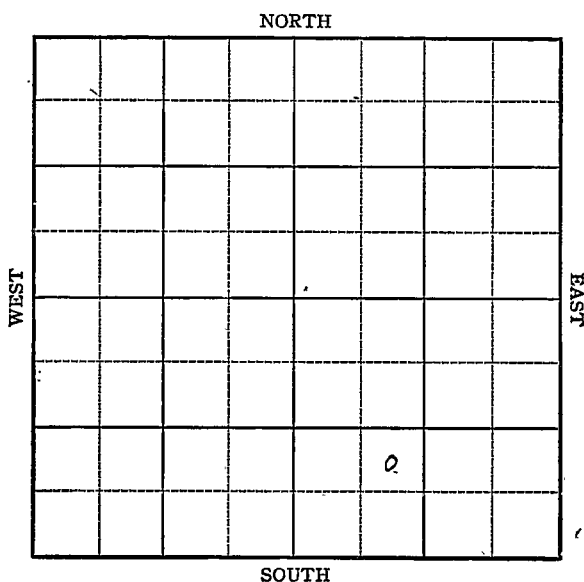


KANSAS

Pratt

FORM 51, 5M PETROL

Section 22 Township 28 Range 12WWell No. #2 Maudsley (*Mawdsley*)Company Lion Oil Ref.

KANSAS

Pratt

Sec. 22 Twp. 28 R. 12W

Well No. #2 Maudsley Farm
Lion Oil Ref. Company

Chitwood

NORTH


 Ft. from N. Line

990 Ft. from S. Line

 Ft. from E. Line

990 Ft. from W. Line

WEST

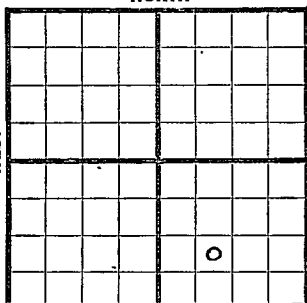

SOUTH

less 1862

1944

REPORT

2/16 Location

2/23 Surface hole

3/1 8" @ 308

Drilling 2800

3/8 3 Lans 3722

Drilling 4187'

3/16 Viola 4374

Simp. Sd. 4387

Arb. 4491-95 TD

Run Casing.

3/22 4495-4502 TD

Miss 4179

Kind 4274

Viola 4381

Simp 4394

Arb 4498

5" @ 4499

Rust

3/29 TD 4502

PB 4450

143 shots 4401-25

Flow 82 oil per hr.

OVER

1944

4/5 1000 acid fow 55 oil per hr.

4 /12 5" @ 4499

Viola 4384

Simp Sd 4394

TB 4502

PB 4450

143 shots to 4401-25

1000 acid

Bomp Pot 3501

Max 3000

Gravity 45

COMPLETED

KANSAS
 Map No. 54 Sec. 22 Twp. 28 R. 12W

Well No. 2 Maudsley

Lion Oil Ref. Company

FIRST REPORT Contractor

NE SW SE

SECTION PLAT

 Ft. from N. Line

990 Ft. from S. Line

 Ft. from E. Line

990 Ft. from W. Line

Chitwood Pool

Location X

Rig up

Drilling and Remarks:

RECORD

Cased in., ft.

Sand

Gas

Oil

Total Depth

PRODUCTION

1st 24 hrs. Nat.

1st 24 hrs. after shot

Gas Cu. Ft.

Dry Hole

Abandoned

Date

FEB 1 6 1944 19 S. J. LEWIS Scout

Misc. Small Maps *Ona*
Cards *Bridge*
Tracing *W. E. L.*
France Map ☒
Scarborough Map ☒
Moody Map ☒
Geological Dept. ☐
Moody Plat Book

Map No. 57 Sec. 22 Twp. 28 R. 12WWell No. 2 Mawdsley

Lion Oil Ref.

Company

COMPLETED

Contractor

NE SW SE

SECTION PLAT

_____ Ft. from N. Line

990 Ft. from S. Line

_____ Ft. from E. Line

990 Ft. from W. Line

Chitwood Pool

Location _____

Rig up _____

Drilling and Remarks:


RECORD

Cased _____ in., _____ ft.

Sand _____

Gas _____

Oil _____

Total Depth 4502

PRODUCTION

1st 24 hrs. Nat. _____

1st 24 hrs. after shot _____


Gas _____ Cu. Ft.

Dry Hole _____

Abandoned _____

APR 12 1944 19

S. J. LEWIS Scout

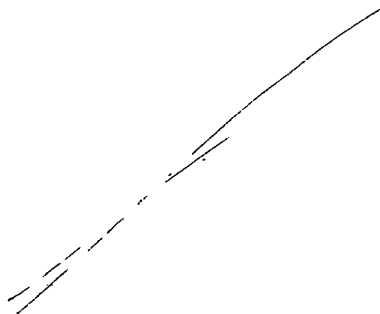

Mi	Shell Maps
Cal	Shadon
Ti	ME
Frank	Map
Scarb	Map
Moody	Map
Geological	Dept.
Moody	Plat-Book